

## WATER WELL RECORD Form WWC-5 KSA 82a-1212

1 LOCATION OF WATER WELL:		Fraction NW 1/4 SE 1/4 NE 1/4	Section Number 11	Township Number T 26 S	Range Number R 28
County: Gray					

Distance and direction from nearest town or city street address of well if located within city?

210 East Avenue A, Cimarron, KS

## 2 WATER WELL OWNER: Grasser Oil Co.


RR#, St. Address, Box #: 210 East Avenue A

Board of Agriculture, Division of Water Resources

City, State, ZIP Code : Cimarron, KS 67835

Application Number:

## 3 LOCATE WELL'S LOCATION WITH AN "X" IN SECTION BOX:

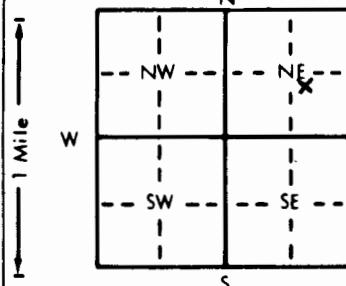

4 DEPTH OF COMPLETED WELL . . . . . ft. ELEVATION: 200.09 . . . . .

Depth(s) Groundwater Encountered 1 . . . . . 162.64 . . . . . ft. 2 . . . . . ft. 3 . . . . . ft.

WELL'S STATIC WATER LEVEL . . . . . 37.45 . . . . . ft. below land surface measured on mo/day/yr 9/23/92 . . . . .

Pump test data: Well water was . . . . . ft. after . . . . . hours pumping . . . . . gpm

Est. Yield . . . . . gpm: Well water was . . . . . ft. after . . . . . hours pumping . . . . . gpm

Bore Hole Diameter . . . . . 6 5/8 . . . . . in. to . . . . . 49 . . . . . ft., and . . . . . in. to . . . . . ft.

WELL WATER TO BE USED AS: 5 Public water supply 8 Air conditioning 11 Injection well

1 Domestic 3 Feedlot 6 Oil field water supply 9 Dewatering 12 Other (Specify below)

2 Irrigation 4 Industrial 7 Lawn and garden only 10 Monitoring well MW-3

Was a chemical/bacteriological sample submitted to Department? Yes . . . . . No . . . . . X; If yes, mo/day/yr sample was submitted

Water Well Disinfected? Yes No X

## 5 TYPE OF BLANK CASING USED:

1 Steel 3 RMP (SR)  
2 PVC 4 ABS

5 Wrought iron 8 Concrete tile CASING JOINTS: Glued . . . . . Clamped . . . . .

6 Asbestos-Cement 9 Other (specify below) Welded X  
7 Fiberglass Threaded . . . . .

Blank casing diameter . . . . . 2 . . . . . in. to . . . . . 27.42 . . . . . ft., Dia . . . . . in. to . . . . . ft., Dia . . . . . in. to . . . . . ft.

Casing height above land surface . . . . . 0 . . . . . in., weight . . . . . lbs./ft. Wall thickness or gauge No. . . . . Sched. 40

## TYPE OF SCREEN OR PERFORATION MATERIAL:

1 Steel 3 Stainless steel 5 Fiberglass 8 RMP (SR)  
2 Brass 4 Galvanized steel 6 Concrete tile 9 ABS  
7 PVC 10 Asbestos-cement  
11 Other (specify) . . . . .  
12 None used (open hole) . . . . .

## SCREEN OR PERFORATION OPENINGS ARE:

1 Continuous slot 3 Mill slot 5 Gauzed wrapped 8 Saw cut 11 None (open hole)  
2 Louvered shutter 4 Key punched 6 Wire wrapped 9 Drilled holes  
7 Torch cut 10 Other (specify) . . . . .

SCREEN-PERFORATED INTERVALS: From . . . . . 47.42 . . . . . ft. to . . . . . 27.42 . . . . . ft., From . . . . . ft. to . . . . . ft.

From . . . . . ft. to . . . . . ft., From . . . . . ft. to . . . . . ft.

GRAVEL PACK INTERVALS: From . . . . . 47.42 . . . . . ft. to . . . . . 25.0 . . . . . ft., From . . . . . ft. to . . . . . ft.

From . . . . . ft. to . . . . . ft., From . . . . . ft. to . . . . . ft.

## 6 GROUT MATERIAL: 1 Neat cement 2 Cement grout 3 Bentonite 4 Other

Grout Intervals: From . . . . . 25.0 . . . . . ft. to . . . . . 22.5 . . . . . ft., From . . . . . 22.5 . . . . . ft. to . . . . . 0.0 . . . . . ft., From . . . . . ft. to . . . . . ft.

What is the nearest source of possible contamination: 10 Livestock pens 14 Abandoned water well  
11 Fuel storage 15 Oil well/Gas well  
12 Fertilizer storage 16 Other (specify below)1 Septic tank 4 Lateral lines 7 Pit privy  
2 Sewer lines 5 Cess pool 8 Sewage lagoon  
3 Watertight sewer lines 6 Seepage pit 9 Feedyard  
13 Insecticide storage . . . . .

Direction from well? How many feet?

FROM	TO	LITHOLOGIC LOG	FROM	TO	PLUGGING INTERVALS
0	5	Clay, Med. Brn., Silty, Lean			
5	10	Clay, Med.-Lt. Brn., Silty, Lean			
10	15	Clay, Med.-Lt. Brn., Silty, Lean			
15	20	Clay, Med. Brn., Lean			
20	25	Clay, Med.-Dk. Brn., Silty, Lean			
25	30	Clay, Dk. Brn.-Dk. Gray			
30	35	Sand, Tan, Rust, Med. Gray, M-C Gr.			
35	40	Sand, Tan, Rust, Med. Gray, C-M Gr. Gravel			
40	45	Sand, C-M Gr., Gravel			
45	49	Sand, C-F Gr., Gravel, Dk. Gray			


Flush Mount approved by

Don Taylor (10-1-92)

KDHE Code # 01035354

## 7 CONTRACTOR'S OR LANDOWNER'S CERTIFICATION: This water well was (1) constructed, (2) reconstructed, or (3) plugged under my jurisdiction and was completed on (mo/day/year) . . . . . 9-1-92 . . . . . and this record is true to the best of my knowledge and belief. Kansas

Water Well Contractor's License No. . . . . 540 . . . . . This Water Well Record was completed on (mo/day/yr) . . . . . 11-18-92 . . . . .

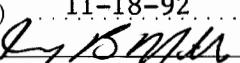under the business name of Prairie Land Environmental Remediation, Inc. (signature) 

INSTRUCTIONS: Use typewriter or ball point pen. PLEASE PRESS FIRMLY and PRINT clearly. Please fill in blanks, underline or circle the correct answers. Send top three copies to Kansas Department of Health and Environment, Bureau of Water, Topeka, Kansas 66620-0001. Telephone: 913-296-5545. Send one to WATER WELL OWNER and retain one for your records.