

CIM 144

WATER WELL RECORD

Form WWC-5

KSA 82a-1212

1 LOCATION OF WATER WELL:

County: Gray

Fraction

SW $\frac{1}{4}$ SE $\frac{1}{4}$ NE $\frac{1}{4}$ NE $\frac{1}{4}$

Section Number

11

Township Number

T

26

S

Range Number

R 28

NW

Distance and direction from nearest town or city street address of well if located within city?

South Third - Blk 38-Lot 12- Orginal Town

2 WATER WELL OWNER: Lynne Wagner


RR#, St. Address, Box #: Box 1102

Board of Agriculture, Division of Water Resources

City, State, ZIP Code: Cimarron, Ks 67835

Application Number:

3 LOCATE WELL'S LOCATION WITH AN "X" IN SECTION BOX:

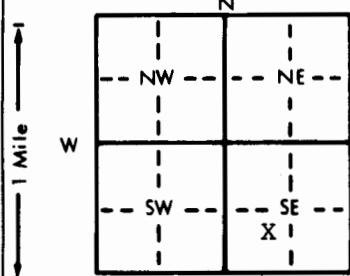

4 DEPTH OF COMPLETED WELL..... ft. ELEVATION:

Depth(s) Groundwater Encountered 1..... ft. 2..... ft. 3..... ft.

WELL'S STATIC WATER LEVEL well filled below land surface measured on mo/day/yr 2-26-90

Pump test data: Well water was 2..... ft. after 1..... hours pumping 1..... gpm

Est. Yield 1..... gpm: Well water was 2..... ft. after 1..... hours pumping 1..... gpm

Bore Hole Diameter 1..... in. to 2..... ft. and 3..... in. to 4..... ft.

WELL WATER TO BE USED AS: 5 Public water supply 8 Air conditioning 11 Injection well

1 Domestic 3 Feedlot 6 Oil field water supply 9 Dewatering 12 Other (Specify below)

2 Irrigation 4 Industrial 7 Lawn and garden only 10 Observation well

Was a chemical/bacteriological sample submitted to Department? Yes..... No..... If yes, mo/day/yr sample was submitted

Water Well Disinfected? Yes..... No.....

5 TYPE OF BLANK CASING USED:

1 Steel 3 RMP (SR)
2 PVC 4 ABS

5 Wrought iron

6 Asbestos-Cement
7 Fiberglass8 Concrete tile
9 Other (specify below)

CASING JOINTS: Glued..... Clamped.....

Welded.....
Threaded.....

Blank casing diameter 1..... in. to 2..... ft. Dia 3..... in. to 4..... ft. Dia 5..... in. to 6..... ft.

Casing height above land surface 4ft. below 1..... in., weight 2..... lbs./ft. Wall thickness or gauge No. 3.....

TYPE OF SCREEN OR PERFORATION MATERIAL:

1 Steel 3 Stainless steel
2 Brass 4 Galvanized steel

7 PVC

8 RMP (SR)
9 ABS

10 Asbestos-cement

11 Other (specify)
12 None used (open hole)

SCREEN OR PERFORATION OPENINGS ARE:

1 Continuous slot 3 Mill slot
2 Louvered shutter 4 Key punched

5 Gauzed wrapped

6 Wire wrapped
7 Torch cut

8 Saw cut

9 Drilled holes
10 Other (specify)

11 None (open hole)

SCREEN-PERFORATED INTERVALS: From 1..... ft. to 2..... ft., From 3..... ft. to 4..... ft., From 5..... ft. to 6..... ft.

From 7..... ft. to 8..... ft., From 9..... ft. to 10..... ft., From 11..... ft. to 12..... ft.

GRAVEL PACK INTERVALS: From 1..... ft. to 2..... ft., From 3..... ft. to 4..... ft., From 5..... ft. to 6..... ft.

From 7..... ft. to 8..... ft., From 9..... ft. to 10..... ft., From 11..... ft. to 12..... ft.

6 GROUT MATERIAL: 1 Neat cement 2 Cement grout 3 Bentonite 4 Other

Grout Intervals: From 1..... ft. to 2..... ft., From 3..... ft. to 4..... ft., From 5..... ft. to 6..... ft., From 7..... ft. to 8..... ft.

What is the nearest source of possible contamination:

1 Septic tank 4 Lateral lines
2 Sewer lines 5 Cess pool
3 Watertight sewer lines 6 Seepage pit

7 Pit privy

8 Sewage lagoon
9 Feedyard

10 Livestock pens

11 Fuel storage
12 Fertilizer storage
13 Insecticide storage

14 Abandoned water well

15 Oil well/Gas well
16 Other (specify below)

Direction from well?

FROM TO LITHOLOGIC LOG FROM TO LITHOLOGIC LOG

Well had been filled previously - no casing visible - cement cased pit

All that remained - 4ft deep - 5'X5' - filled pit with fill sand -

6" concrete cap over pit

7 CONTRACTOR'S OR LANDOWNER'S CERTIFICATION: This water well was (1) constructed, (2) reconstructed, or (3) plugged under my jurisdiction and was completed on (mo/day/year) 3-2-90 and this record is true to the best of my knowledge and belief. Kansas

Water Well Contractor's License No. 1179 This Water Well Record was completed on (mo/day/yr) 3-15-90
under the business name of *Yours Well Service* by (signature) *Larry Erick*