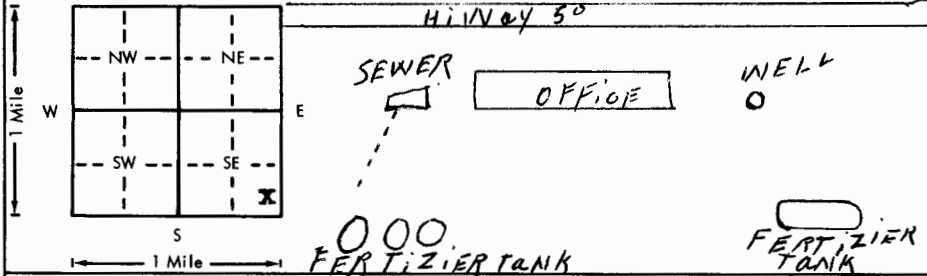


USE TYPEWRITER OR BALL  
POINT PEN-PRESS FIRMLY,  
PRINT CLEARLY.

WATER WELL RECORD  
KSA 82a-1201-1215

Kansas Department of Health and  
Environment-Division of Environment  
(Water well Contractors)  
Topeka, Kansas 66620

CORRECTED COPY

1. Location of well:		County <b>Gray</b>	Fraction <b>SE 1/4 SE 1/4 NW 1/4</b>	Section number <b>#11</b>	Township number <b>T #26</b>	Range number <b>S R #28</b>
2. Distance and direction from nearest town or city: <b>on Highway 50.</b> Street address of well location if in city:			3. Owner of well: <b>Waits Homegas</b> R.R. or street: <b>% Bud Byers</b> City, state, zip code: <b>Cimarron, Kansas 67835</b>			
4. Locate with "X" in section below:			Sketch map:			6. Bore hole dia. <b>180</b> in. Completion date <b>7-25-76</b> Well depth <b>8</b> ft.
						7. Cable tool <input checked="" type="checkbox"/> Rotary <input type="checkbox"/> Driven <input type="checkbox"/> Dug <input type="checkbox"/> Hollow rod <input type="checkbox"/> Jetted <input type="checkbox"/> Bored <input type="checkbox"/> Reverse rotary
5. Type and color of material			From	To	8. Use: <input checked="" type="checkbox"/> Domestic <input type="checkbox"/> Public supply <input type="checkbox"/> Industry <input type="checkbox"/> Irrigation <input type="checkbox"/> Air conditioning <input type="checkbox"/> Stock <input type="checkbox"/> Lawn <input type="checkbox"/> Oil field water <input type="checkbox"/> Other	
Top soil & clay			0	15	9. Casing: Material <b>RMP</b> Height: Above or below Threaded <input type="checkbox"/> Welded <input type="checkbox"/> Surface <b>12</b> in. RMP <input checked="" type="checkbox"/> PVC <input type="checkbox"/> Weight <input type="checkbox"/> lbs./ft. Dia. <b>5</b> in. to <b>180</b> ft. depth Wall Thickness: inches or Dia. <input type="checkbox"/> in. to <input type="checkbox"/> ft. depth gage No. <b>250</b>	
Clay & coarse sand			15	30	10. Screen: Manufacturer's name <b>Sunflower</b> Type <b>RMP</b> Dia. <b>5"</b> Slot/gauze <b>1/8"</b> Length <b>20 ft.</b> Set between <b>155</b> ft. and <b>175</b> ft. ft. and <input type="checkbox"/> ft. Gravel pack? <b>yes</b> Size range of material <b>1"</b>	
Coarse sand			30	45	11. Static water level: <input type="checkbox"/> mo./day/yr. <b>48</b> ft. below land surface Date <b>7-25-76</b>	
Coarse sand & clay			45	60	12. Pumping level below land surfaces: <b>72</b> ft. after <b>2</b> hrs. pumping <b>80</b> g.p.m. ft. after <input type="checkbox"/> hrs. pumping <input type="checkbox"/> g.p.m. Estimated maximum yield <b>125</b> g.p.m.	
Clay			60	75	13. Water sample submitted: <input type="checkbox"/> Yes <input checked="" type="checkbox"/> No Date <input type="checkbox"/>	
Clay layers & fine sand			75	90	14. Well head completion: <input checked="" type="checkbox"/> Pitless adapter <b>12</b> inches above grade	
Fine sand			90	120	15. Well grouted? <b>yes</b> With: <input checked="" type="checkbox"/> Neat cement <input type="checkbox"/> Bentonite <input type="checkbox"/> Concrete Depth: From <b>10</b> ft. to <b>20</b> ft.	
Fine sand to medium sand			120	135	16. Nearest source of possible contamination: ft. <b>70</b> Direction <b>South &amp; West</b> Plant <b>Fertilizer</b> Well disinfected upon completion? <input checked="" type="checkbox"/> Yes <input type="checkbox"/> No	
Medium sand & clay			135	150	17. Pump: <input type="checkbox"/> Not installed Manufacturer's name <b>Flint &amp; Walling</b> Model number <b>10BK9</b> HP <b>1</b> Volts <b>230</b> Length of drop pipe <b>105</b> ft. capacity <b>19</b> g.p.m. Type: <input checked="" type="checkbox"/> Submersible <input type="checkbox"/> Turbine <input type="checkbox"/> Jet <input type="checkbox"/> Reciprocating <input type="checkbox"/> Centrifugal <input type="checkbox"/> Other	
Clay & coarse sand			150	165		
Coarse sand & clay			165	180		
(Use a second sheet if needed)						
18. Elevation:		19. Remarks:				
Topography: <input type="checkbox"/> Hill <input type="checkbox"/> Slope <input checked="" type="checkbox"/> Upland <input type="checkbox"/> Valley		20. Water well contractor's certification: This well was drilled under my jurisdiction and this report is true to the best of my knowledge and belief. <b>JOE'S WELL SERVICE</b> <b>179</b> Business name License No. Address <b>Box 174 Cimarron, Ks.</b> Signed <b>Paul Chick</b> Date <b>9-4-76</b> Authorized representative				

Forward the white, blue and pink copies to the Department of Health and Environment

Form WWC-5