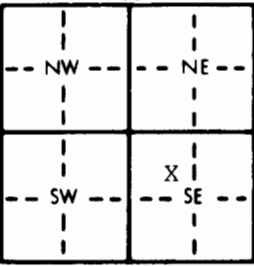


1 LOCATION OF WATER WELL: County: <u>Gray</u>		Fraction <u>NE 1/4 NW 1/4 SE 1/4</u>		Section Number <u>11</u>	Township Number <u>T 26 S</u>	Range Number <u>R 28</u>	
Distance and direction from nearest town or city street address of well if located within city? <u>Block 61 #3</u>	
2 WATER WELL OWNER: <u>City of Cimarron</u> RR#, St. Address, Box # : City, State, ZIP Code : <u>Cimarron, Ks. 67835</u>	
Board of Agriculture, Division of Water Resources Application Number: <u>SW#3 (30 of 168)</u>	
3 LOCATE WELL'S LOCATION WITH AN "X" IN SECTION BOX: <div style="text-align: center;"></div> Map Attached <u>3d</u>		4 DEPTH OF COMPLETED WELL: <u>150'</u> ft. ELEVATION: _____ Depth(s) Groundwater Encountered 1. _____ ft. 2. _____ ft. 3. _____ ft. WELL'S STATIC WATER LEVEL <u>17'</u> ft. below land surface measured on mo/day/yr Pump test data: Well water was _____ ft. after _____ hours pumping _____ gpm Est. Yield _____ gpm: Well water was _____ ft. after _____ hours pumping _____ gpm Bore Hole Diameter _____ in. to _____ ft., and _____ in. to _____ ft. WELL WATER TO BE USED AS: <table border="0" style="width:100%;"><tr><td>1 Domestic</td><td>3 Feedlot</td><td>6 Oil field water supply</td><td>9 Dewatering</td><td>12 Other (Specify below)</td></tr><tr><td>2 Irrigation</td><td>4 Industrial</td><td>7 Lawn and garden only</td><td>10 Observation well</td><td></td></tr></table> Was a chemical/bacteriological sample submitted to Department? Yes _____ No <u>✓</u> ; If yes, mo/day/yr sample was submitted _____ Water Well Disinfected? Yes _____ No <u>✓</u>					1 Domestic	3 Feedlot	6 Oil field water supply	9 Dewatering	12 Other (Specify below)	2 Irrigation	4 Industrial	7 Lawn and garden only	10 Observation well																																							
1 Domestic	3 Feedlot	6 Oil field water supply	9 Dewatering	12 Other (Specify below)	
2 Irrigation	4 Industrial	7 Lawn and garden only	10 Observation well	
5 TYPE OF BLANK CASING USED: <table border="0" style="width:100%;"><tr><td>1 Steel</td><td>3 RMP (SR)</td><td>6 Asbestos-Cement</td><td>9 Other (specify below)</td><td></td></tr><tr><td>2 PVC</td><td>4 ABS</td><td>7 Fiberglass</td><td></td><td></td></tr></table> Blank casing diameter _____ in. to _____ ft., Dia. _____ in. to _____ ft., Dia. _____ in. to _____ ft. Casing height above land surface _____ in., weight _____ lbs./ft. Wall thickness or gauge No. _____ TYPE OF SCREEN OR PERFORATION MATERIAL: <table border="0" style="width:100%;"><tr><td>1 Steel</td><td>3 Stainless steel</td><td>5 Fiberglass</td><td>8 RMP (SR)</td><td>11 Other (specify)</td></tr><tr><td>2 Brass</td><td>4 Galvanized steel</td><td>6 Concrete tile</td><td>9 ABS</td><td>12 None used (open hole)</td></tr></table> SCREEN OR PERFORATION OPENINGS ARE: <u>N/A</u> <table border="0" style="width:100%;"><tr><td>1 Continuous slot</td><td>3 Mill slot</td><td>5 Gauzed wrapped</td><td>8 Saw cut</td><td>11 None (open hole)</td></tr><tr><td>2 Louvered shutter</td><td>4 Key punched</td><td>6 Wire wrapped</td><td>9 Drilled holes</td><td></td></tr><tr><td></td><td></td><td>7 Torch cut</td><td>10 Other (specify)</td><td></td></tr></table> SCREEN-PERFORATED INTERVALS: From <u>N/A</u> ft. to _____ ft., From _____ ft. to _____ ft. From _____ ft. to _____ ft., From _____ ft. to _____ ft. GRAVEL PACK INTERVALS: From <u>N/A</u> ft. to _____ ft., From _____ ft. to _____ ft. From _____ ft. to _____ ft., From _____ ft. to _____ ft.							1 Steel	3 RMP (SR)	6 Asbestos-Cement	9 Other (specify below)		2 PVC	4 ABS	7 Fiberglass			1 Steel	3 Stainless steel	5 Fiberglass	8 RMP (SR)	11 Other (specify)	2 Brass	4 Galvanized steel	6 Concrete tile	9 ABS	12 None used (open hole)	1 Continuous slot	3 Mill slot	5 Gauzed wrapped	8 Saw cut	11 None (open hole)	2 Louvered shutter	4 Key punched	6 Wire wrapped	9 Drilled holes				7 Torch cut	10 Other (specify)														
1 Steel	3 RMP (SR)	6 Asbestos-Cement	9 Other (specify below)	
2 PVC	4 ABS	7 Fiberglass	
1 Steel	3 Stainless steel	5 Fiberglass	8 RMP (SR)	11 Other (specify)	
2 Brass	4 Galvanized steel	6 Concrete tile	9 ABS	12 None used (open hole)	
1 Continuous slot	3 Mill slot	5 Gauzed wrapped	8 Saw cut	11 None (open hole)	
2 Louvered shutter	4 Key punched	6 Wire wrapped	9 Drilled holes	
		7 Torch cut	10 Other (specify)	
6 GROUT MATERIAL: 1 Neat cement 2 Cement grout 3 <u>Bentonite</u> 4 Other <u>Chlorinated gravel</u> Grout Intervals: From <u>6' Below ground</u> ft. to <u>13</u> ft., From <u>13</u> ft. to <u>17</u> ft., From <u>17</u> ft. to <u>150</u> ft. What is the nearest source of possible contamination: <table border="0" style="width:100%;"><tr><td>1 Septic tank</td><td>4 Lateral lines</td><td>7 Pit privy</td><td>10 Livestock pens</td><td>14 Abandoned water well</td></tr><tr><td>2 Sewer lines</td><td>5 Cess pool</td><td>8 Sewage lagoon</td><td>11 Fuel storage</td><td>15 Oil well/Gas well</td></tr><tr><td>3 Watertight sewer lines</td><td>6 Seepage pit</td><td>9 Feedyard</td><td>12 Fertilizer storage</td><td>16 Other (specify below)</td></tr><tr><td></td><td></td><td></td><td>13 Insecticide storage</td><td>River Flooding</td></tr></table> Direction from well? <u>Possible sewer lines</u> How many feet? <u>River 1/2 mile South</u>							1 Septic tank	4 Lateral lines	7 Pit privy	10 Livestock pens	14 Abandoned water well	2 Sewer lines	5 Cess pool	8 Sewage lagoon	11 Fuel storage	15 Oil well/Gas well	3 Watertight sewer lines	6 Seepage pit	9 Feedyard	12 Fertilizer storage	16 Other (specify below)				13 Insecticide storage	River Flooding																												
1 Septic tank	4 Lateral lines	7 Pit privy	10 Livestock pens	14 Abandoned water well	
2 Sewer lines	5 Cess pool	8 Sewage lagoon	11 Fuel storage	15 Oil well/Gas well	
3 Watertight sewer lines	6 Seepage pit	9 Feedyard	12 Fertilizer storage	16 Other (specify below)	
			13 Insecticide storage	River Flooding	
<table border="1" style="width:100%; border-collapse: collapse;"><thead><tr><th>FROM</th><th>TO</th><th>LITHOLOGIC LOG</th><th>FROM</th><th>TO</th><th>LITHOLOGIC LOG</th></tr></thead><tbody><tr><td></td><td></td><td>#3 of Battery of 5 Wells</td><td></td><td></td><td></td></tr><tr><td>0</td><td>8</td><td>" Cement</td><td></td><td></td><td></td></tr><tr><td>8</td><td>6</td><td>" Clay & Sandy Soil</td><td></td><td></td><td></td></tr><tr><td>6</td><td>13</td><td>" Neat Cement</td><td></td><td></td><td></td></tr><tr><td>13</td><td>17</td><td>" Bentonite</td><td></td><td></td><td></td></tr><tr><td>17</td><td>150</td><td>" Chlorinated gravel pack</td><td></td><td></td><td></td></tr><tr><td colspan="6">This well is one of a battery of 5 wells. The pit is cement with a cement floor. The bottom of the pit was filled with neat cement above the casing. The rest of the pit was filled with clay and sandy soil. The top end of the pit and man hole was cemented to prevent moisture collecting in the pit.</td></tr></tbody></table>							FROM	TO	LITHOLOGIC LOG	FROM	TO	LITHOLOGIC LOG			#3 of Battery of 5 Wells				0	8	" Cement				8	6	" Clay & Sandy Soil				6	13	" Neat Cement				13	17	" Bentonite				17	150	" Chlorinated gravel pack				This well is one of a battery of 5 wells. The pit is cement with a cement floor. The bottom of the pit was filled with neat cement above the casing. The rest of the pit was filled with clay and sandy soil. The top end of the pit and man hole was cemented to prevent moisture collecting in the pit.					
FROM	TO	LITHOLOGIC LOG	FROM	TO	LITHOLOGIC LOG	
		#3 of Battery of 5 Wells	
0	8	" Cement	
8	6	" Clay & Sandy Soil	
6	13	" Neat Cement	
13	17	" Bentonite	
17	150	" Chlorinated gravel pack	
This well is one of a battery of 5 wells. The pit is cement with a cement floor. The bottom of the pit was filled with neat cement above the casing. The rest of the pit was filled with clay and sandy soil. The top end of the pit and man hole was cemented to prevent moisture collecting in the pit.	
7 CONTRACTOR'S OR LANDOWNER'S CERTIFICATION: This water well was (1) constructed, (2) reconstructed, or (3) <u>plugged</u> under my jurisdiction and was completed on (mo/day/year) <u>5/26/88</u> and this record is true to the best of my knowledge and belief. Kansas Water Well Contractor's License No. <u>145</u> This Water Well Record was completed on (mo/day/yr) <u>6/7/88</u> under the business name of <u>Henkle Drilling & Supply Company, Inc.</u> by (signature) <u>Paul Richman</u>	
INSTRUCTIONS: Use typewriter or ball point pen. PLEASE PRESS FIRMLY and PRINT clearly. Please fill in blanks, underline or circle the correct answers. Send top three copies to Kansas Department of Health and Environment, Bureau of Water Protection, Topeka, Kansas 66620-7320, Telephone: 913-862-9360. Send one to WATER WELL OWNER and retain one for your records.	

OFFICE USE ONLY

T

R


EW

SEC.

1/4

1/4

1/4

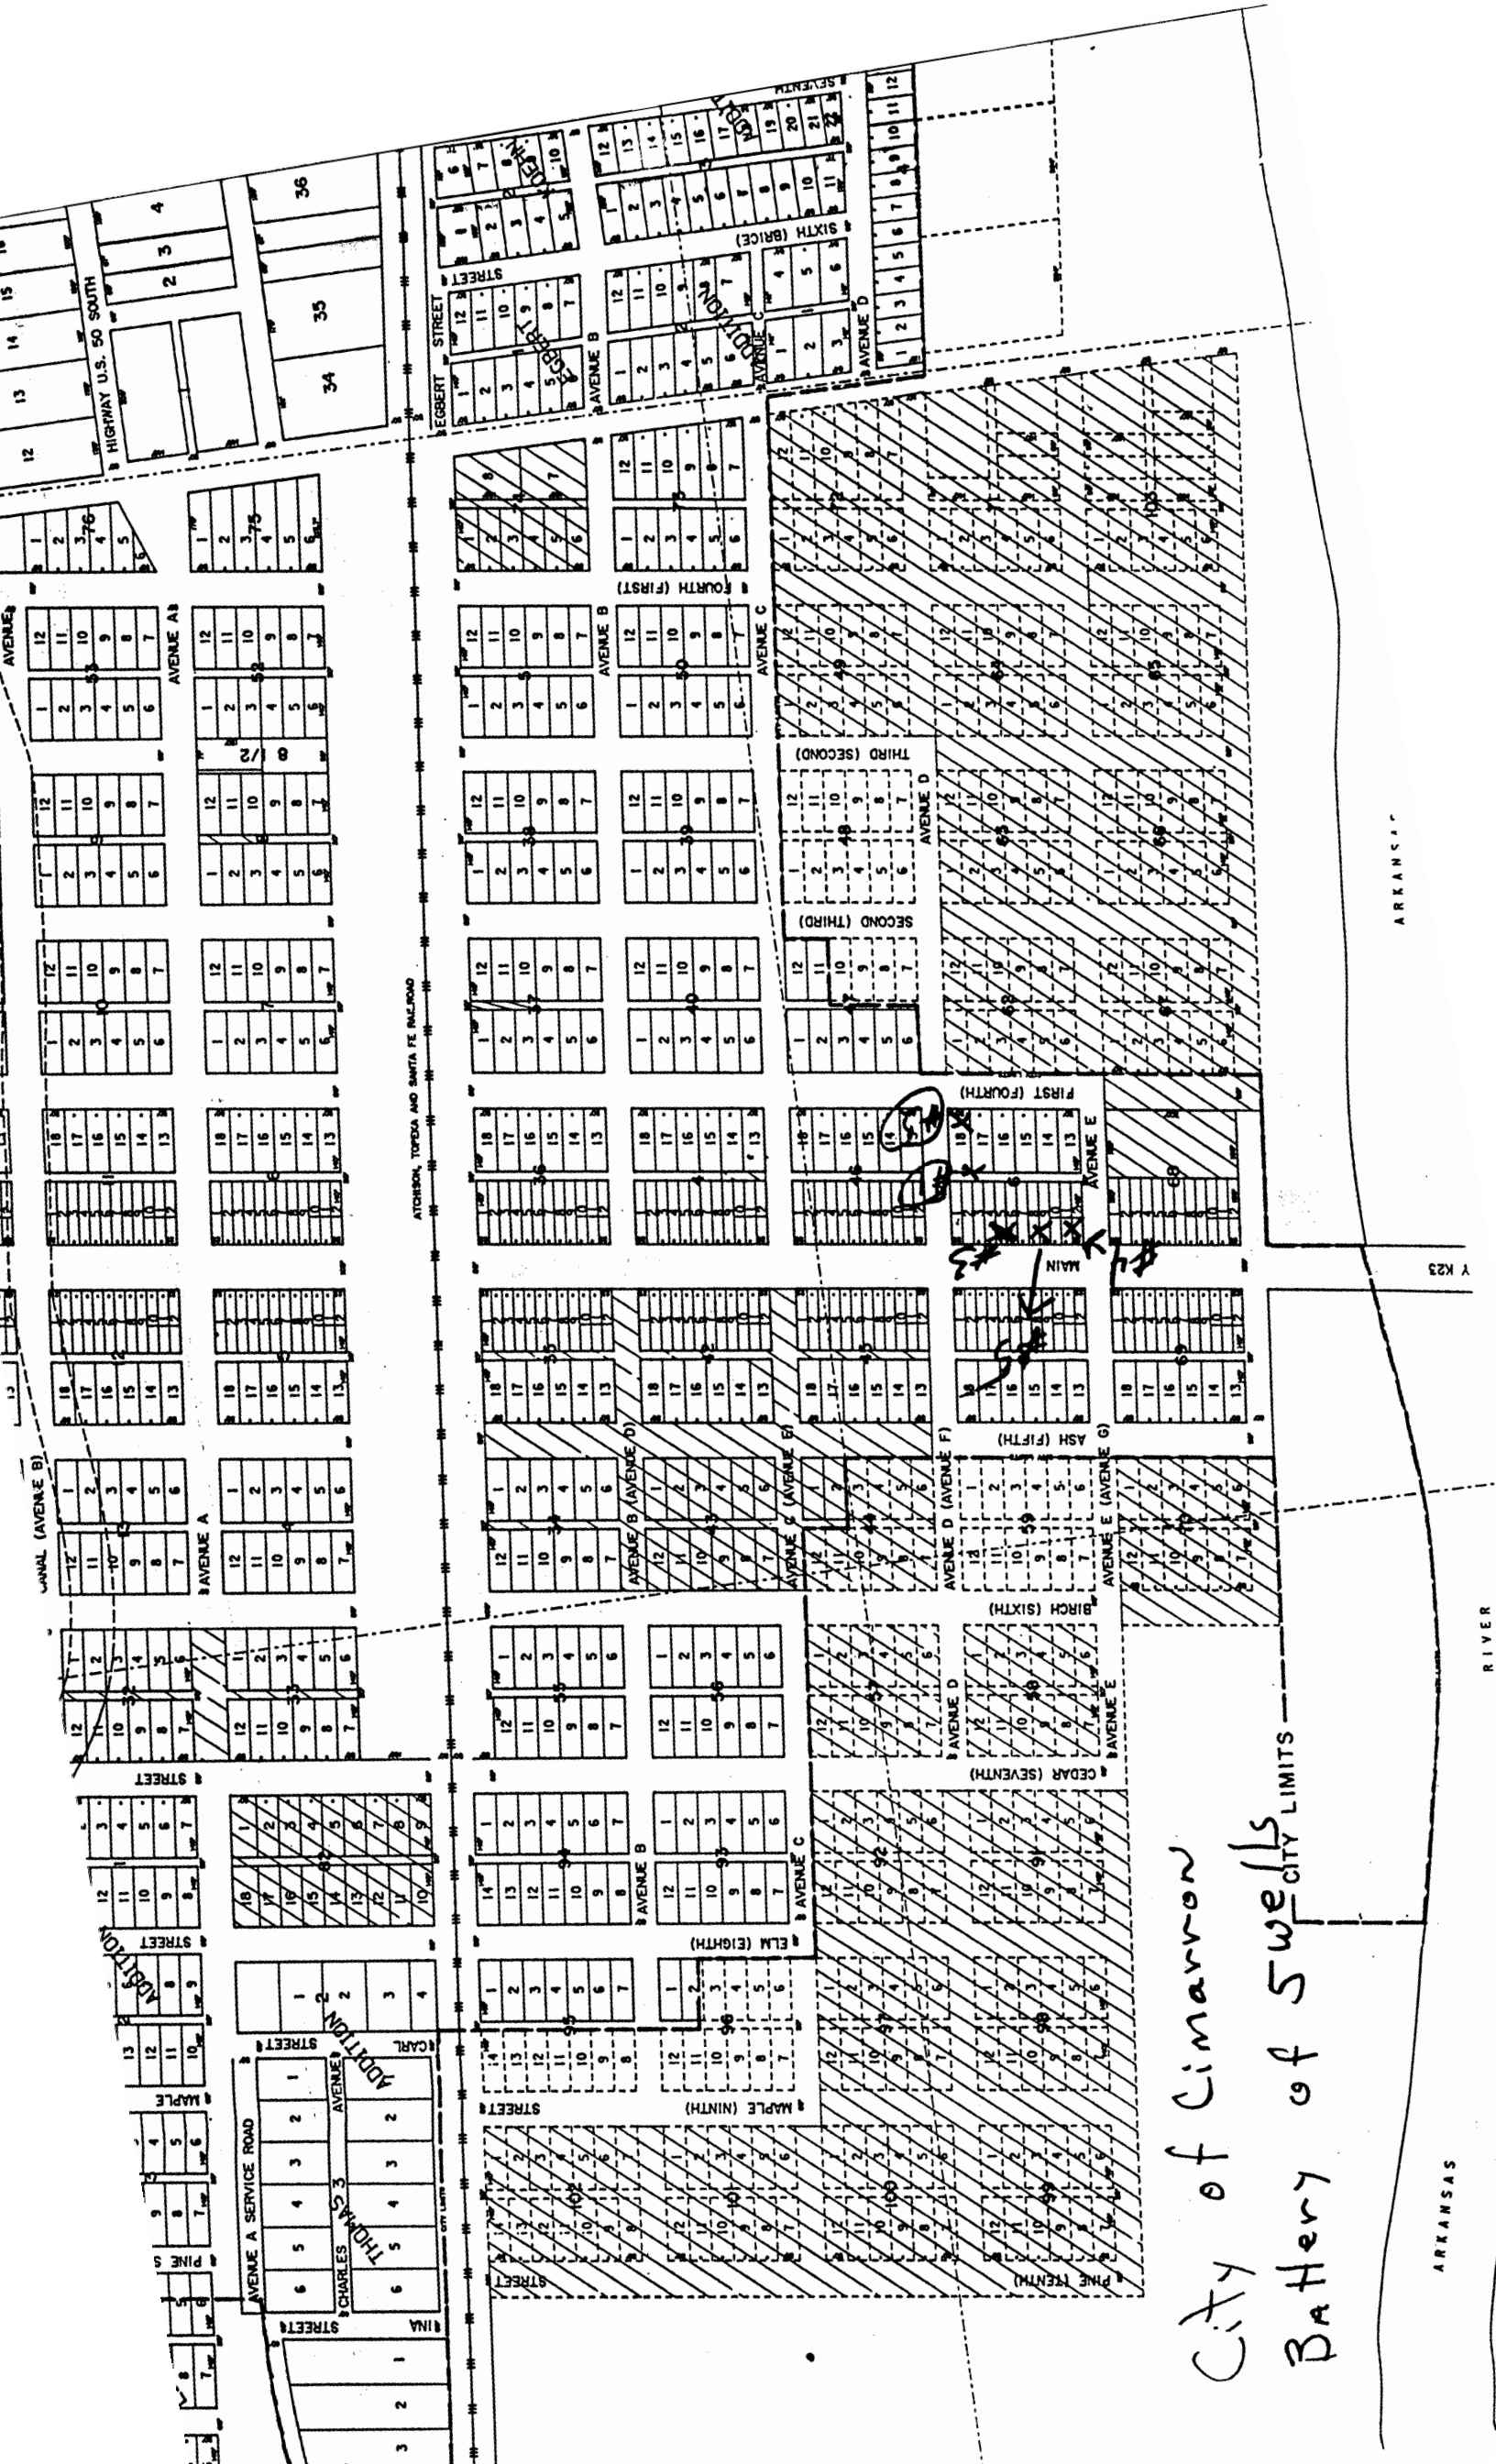

City of Cimarron
Battery of Swells

ARKANSAS

ARKANSAS

RIVER

Y K23