
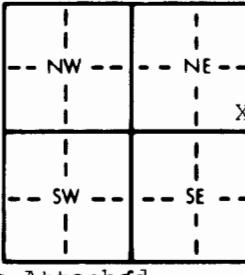


WATER WELL RECORD Form WWC-5 KSA 82a-1212

1 LOCATION OF WATER WELL:		Fraction SE 1/4 SE 1/4 NE 1/4	Section Number 11	Township Number T 26 S	Range Number R 28 EW		
Distance and direction from nearest town or city street address of well if located within city? Egbert St. Lot 8 Block 74							
2 WATER WELL OWNER:		City of Cimarron					
RR#, St. Address, Box # :		Board of Agriculture, Division of Water Resources					
City, State, ZIP Code :		Application Number: SW#3 (23 of 168)					
3 LOCATE WELL'S LOCATION WITH AN "X" IN SECTION BOX:		4 DEPTH OF COMPLETED WELL... N/A ft. ELEVATION:					
 Map Attached		Depth(s) Groundwater Encountered 1... N/A ft. 2... ft. 3... ft. WELL'S STATIC WATER LEVEL N/A ft. below land surface measured on mo/day/yr Pump test data: Well water was ft. after hours pumping gpm Est. Yield gpm: Well water was ft. after hours pumping gpm Bore Hole Diameter..... in. to ft. and in. to ft. WELL WATER WAS USED AS: 5 Public water supply 8 Air conditioning 11 Injection well 1 Domestic 3 Feedlot 6 Oil field water supply 9 Dewatering 12 Other (Specify below) 2 Irrigation 4 Industrial 7 Lawn and garden only 10 Observation well Was a chemical/bacteriological sample submitted to Department? Yes..... No..... If yes, mo/day/yr sample was submitted					
5 TYPE OF BLANK CASING USED:		5 Wrought iron 1 Steel 2 PVC	8 Concrete tile 9 Other (specify below)	CASING JOINTS: Glued Clamped Welded Threaded			
Blank casing diameter 8" in. to ft., Dia in. to ft., Dia in. to ft.		lbs./ft. Wall thickness or gauge No.					
Casing height above land surface 4' below ground, weight		lbs./ft. Wall thickness or gauge No.					
TYPE OF SCREEN OR PERFORATION MATERIAL:		N/A	7 PVC 5 Fiberglass 6 Concrete tile	10 Asbestos-cement 11 Other (specify) 12 None used (open hole)			
SCREEN OR PERFORATION OPENINGS ARE:		N/A	5 Gauzed wrapped 6 Wire wrapped 7 Torch cut	8 Saw cut 9 Drilled holes 10 Other (specify)			
SCREEN-PERFORATED INTERVALS:		From..... N/A ft. to ft., From..... ft. to ft., From..... ft. to ft.	11 None (open hole)				
GRAVEL PACK INTERVALS:		From..... ft. to ft., From..... ft. to ft., From..... ft. to ft.	ft. to ft., From..... ft. to ft., From..... ft. to ft.				
6 GROUT MATERIAL:		1 Neat cement Grout Intervals: From 4' below ground ft. to ft., From ft. to ft., From ft. to ft.	2 Cement grout From..... ft. to ft., From..... ft. to ft., From..... ft. to ft.	3 Bentonite From..... ft. to ft., From..... ft. to ft., From..... ft. to ft.	4 Other		
What is the nearest source of possible contamination:		10 Livestock pens 11 Fuel storage 12 Fertilizer storage 13 Insecticide storage 14 Abandoned water well 15 Oil well/Gas well 16 Other (specify below) *Inactive City Well					
Direction from well? South		How many feet? 225'					
FROM	TO	LITHOLOGIC LOG		FROM	TO	LITHOLOGIC LOG	
0	4	Clay and Sandy Soil.					
4	7	Neat Cement					
Old well had concrete foundation & pit 4' X 4' X 7'. Removed and found casing. Well had been filled with gravel in past. Chlorinated gravel pack, also removed gravel approximately 2' down into casing. Used neat cement to fill casing, also ran neat cement pad around casing, 3' X 3' x 30". Filled with clay material to ground level.							
7 CONTRACTOR'S OR LANDOWNER'S CERTIFICATION: This water well was (1) constructed, (2) reconstructed, or (3) plugged under my jurisdiction and was completed on (mo/day/year) 5/17/88..... and this record is true to the best of my knowledge and belief. Kansas Water Well Contractor's License No. 145..... This Water Well Record was completed on (mo/day/yr) .. 6/6/88..... under the business name of Henkle Drilling & Supply Company, Inc. by (signature) 							
INSTRUCTIONS: Use typewriter or ball point pen. PLEASE PRESS FIRMLY and PRINT clearly. Please fill in blanks, underline or circle the correct answers. Send top three copies to Kansas Department of Health and Environment, Bureau of Water Protection, Topeka, Kansas 66620-7320, Telephone: 913-862-9360. Send one to WATER WELL OWNER and retain one for your records							

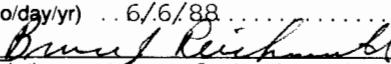