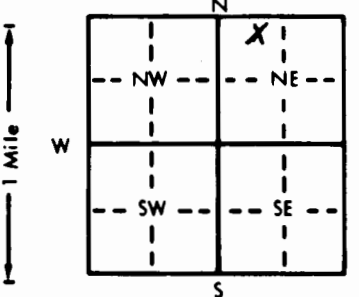


1 LOCATION OF WATER WELL:		Fraction	Section Number	Township Number	Range Number
County: Gray		NW 1/4 NW 1/4 NE 1/4	11	T 26 S	R 28 EW
Distance and direction from nearest town or city street address of well if located within city? Blk 29 - Lot 1 - Original Town, City of Cimarron, Ks (no work sheet)					
2 WATER WELL OWNER: Roy and/or Lavon Timken					
RR#, St. Address, Box # : Box 414			Board of Agriculture, Division of Water Resources		
City, State, ZIP Code : Cimarron, Ks 67835			Application Number:		
3 LOCATE WELL'S LOCATION WITH AN "X" IN SECTION BOX:		4 DEPTH OF COMPLETED WELL: 200 ft. ELEVATION:			
		Depth(s) Groundwater Encountered 1. ft. 2. ft. 3. ft. WELL'S STATIC WATER LEVEL 77 ft. below land surface measured on mo/day/yr 4-19-90 Pump test data: Well water was ft. after hours pumping gpm Est. Yield gpm: Well water was ft. after hours pumping gpm Bore Hole Diameter in. to ft., and in. to ft. WELL WATER TO BE USED AS: 5 Public water supply 8 Air conditioning 11 Injection well 1 Domestic 3 Feedlot 6 Oil field water supply 9 Dewatering 12 Other (Specify below) unknown 2 Irrigation 4 Industrial 7 Lawn and garden only 10 Observation well Was a chemical/bacteriological sample submitted to Department? Yes No X If yes, mo/day/yr sample was submitted Water Well Disinfected? Yes No			
5 TYPE OF BLANK CASING USED:					
1 Steel 3 RMP (SR) 5 Wrought iron 8 Concrete tile CASING JOINTS: Glued Clamped		6 Asbestos-Cement 9 Other (specify below) Welded			
2 PVC 4 ABS 7 Fiberglass Threaded					
Blank casing diameter in. to ft., Dia 6 in. to ft., Dia in. to ft.					
Casing height above land surface in., weight lbs./ft. Wall thickness or gauge No.					
TYPE OF SCREEN OR PERFORATION MATERIAL:					
1 Steel 3 Stainless steel 5 Fiberglass 8 RMP (SR) 10 Asbestos-cement		11 Other (specify) unknown			
2 Brass 4 Galvanized steel 6 Concrete tile 9 ABS 12 None used (open hole)					
SCREEN OR PERFORATION OPENINGS ARE:					
1 Continuous slot 3 Mill slot 5 Gauzed wrapped 8 Saw cut 11 None (open hole)		6 Wire wrapped 9 Drilled holes			
2 Louvered shutter 4 Key punched 7 Torch cut 10 Other (specify)					
SCREEN-PERFORATED INTERVALS: From ft. to ft., From ft. to ft.					
GRAVEL PACK INTERVALS: From ft. to ft., From ft. to ft.					
6 GROUT MATERIAL: 1 Neat cement 2 Cement grout 3 Bentonite 4 Other					
Grout Intervals: From ft. to ft., From ft. to ft., From ft. to ft.					
What is the nearest source of possible contamination:					
1 Septic tank 4 Lateral lines 7 Pit privy 10 Livestock pens 14 Abandoned water well		11 Fuel storage 15 Oil well/Gas well			
2 Sewer lines 5 Cess pool 8 Sewage lagoon 12 Fertilizer storage 16 Other (specify below)					
3 Watertight sewer lines 6 Seepage pit west 9 Feedyard 13 Insecticide storage		How many feet? 100			
Direction from well?					
FROM	TO	LITHOLOGIC LOG	FROM	TO	LITHOLOGIC LOG
		this well was on the property when I purchased it - sodo not know how well was co-			nstructed pump jack sits on concrete slab 3' X3' after plugging well for
		ordamental effect, grouted pump jack back-			pipe in concrete 1 ft.
0'	2'	concrete plug			
2'	7'	bentonite			
7'	200'	chlorinated sand			
7 CONTRACTOR'S OR LANDOWNER'S CERTIFICATION: This water well was (1) constructed, (2) reconstructed, or (3) plugged under my jurisdiction and was completed on (mo/day/year) 4-19-90 and this record is true to the best of my knowledge and belief. Kansas					
Water Well Contractor's License No. This Water Well Record was completed on (mo/day/yr) 4-19-90					
under the business name of by (signature) Lavon Timken					
INSTRUCTIONS: Use typewriter or ball point pen. PLEASE PRESS FIRMLY and PRINT clearly. Please fill in blanks, underline or circle the correct answers. Send top three copies to Kansas Department of Health and Environment, Bureau of Water Protection, Topeka, Kansas 66620-7320, Telephone: 913-862-9360. Send one to WATER WELL OWNER and retain one for your records.					

OFFICE USE ONLY

T

R

EW

SEC.

1/4

1/4

1/4