

WATER WELL RECORD

Form WWC-5

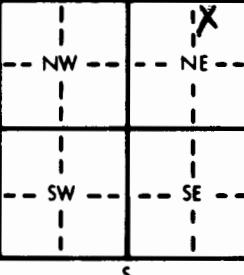
KSA 82a-1212

1 LOCATION OF WATER WELL:		Fraction County: Gray NW $\frac{1}{4}$ NE $\frac{1}{4}$ NE $\frac{1}{4}$	Section Number 12	Township Number T 26 S	Range Number R 28 EW
---------------------------	--	--	----------------------	---------------------------	-------------------------

Distance and direction from nearest town or city street address of well if located within city?

From Cimarron, Ks. - 1 mile East on highway 50

2 WATER WELL OWNER: Wayne Davis

RR#, St. Address, Box #: _____
City, State, ZIP Code : Cimarron, Kansas 67835Board of Agriculture, Division of Water Resources
Application Number: _____3 LOCATE WELL'S LOCATION WITH AN "X" IN SECTION BOX:
N  E
W S

4 DEPTH OF COMPLETED WELL ... 225 ft. ELEVATION: _____
 Depth(s) Groundwater Encountered 1. ft. 2. ft. 3. ft.
 WELL'S STATIC WATER LEVEL ... 75 ft. below land surface measured on mo/day/yr August 13, 1986
 Pump test data: Well water was 80 ft. after 2 hours pumping 70 gpm
 Est. Yield 80 gpm: Well water was ft. after hours pumping gpm
 Bore Hole Diameter 8 in. to 225 ft. and in. to ft.
 WELL WATER TO BE USED AS: 5 Public water supply 8 Air conditioning 11 Injection well
 1 Domestic 3 Feedlot 6 Oil field water supply 9 Dewatering 12 Other (Specify below)
 2 Irrigation 4 Industrial 7 Lawn and garden only 10 Observation well

Was a chemical/bacteriological sample submitted to Department? Yes XX; If yes, mo/day/yr sample was submitted

Water Well Disinfected? Yes XX No

5 TYPE OF BLANK CASING USED:
 1 Steel 3 RMP (SR) 5 Wrought iron 8 Concrete tile Casing joints: Glued XX Clamped
 2 PVC 4 ABS 6 Asbestos-Cement 9 Other (specify below) Welded
 Blank casing diameter 5 in. to 225 ft. Dia in. to ft. Dia in. to in. to ft.

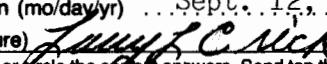
Casing height above land surface 12 in. weight 200 psi lbs./ft. Wall thickness or gauge No. SDR 21

TYPE OF SCREEN OR PERFORATION MATERIAL:
 1 Steel 3 Stainless steel 5 Fiberglass 7 PVC 10 Asbestos-cement
 2 Brass 4 Galvanized steel 6 Concrete tile 8 RMP (SR) 11 Other (specify)
 9 ABS 12 None used (open hole)SCREEN OR PERFORATION OPENINGS ARE:
 1 Continuous slot 3 Mill slot 5 Gauzed wrapped 8 Saw cut 11 None (open hole)
 2 Louvered shutter 4 Key punched 6 Wire wrapped 9 Drilled holes
 7 Torch cut 10 Other (specify)SCREEN-PERFORATED INTERVALS: From 200 ft. to 220 ft., From ft. to ft. to ft.
 From ft. to ft., From ft. to ft. to ft.GRAVEL PACK INTERVALS: From 20 ft. to 60 ft., From ft. to ft. to ft.
 From 75 ft. to 225 ft., From ft. to ft. to ft.6 GROUT MATERIAL: 1 Neat cement 2 Cement grout 3 Bentonite 4 Other
 Grout Intervals: From 6 ft. to 20 ft., From 60 ft. to 75 ft., From ft. to ft.What is the nearest source of possible contamination: none 10 Livestock pens 14 Abandoned water well
 1 Septic tank 4 Lateral lines 7 Pit privy 11 Fuel storage 15 Oil well/Gas well
 2 Sewer lines 5 Cess pool 8 Sewage lagoon 12 Fertilizer storage 16 Other (specify below)
 3 Watertight sewer lines 6 Seepage pit 9 Feedyard

Direction from well? How many feet?

FROM	TO	LITHOLOGIC LOG	FROM	TO	LITHOLOGIC LOG
0	15	Top soil & clay			
15	30	Clay			
30	45	Clay (2 ft.) & medium to coarse sand			
45	60	Medium to coarse sand (very loose) & clay (2 ft.)			
60	75	Clay			
75	90	Clay & fine sand in layers			
90	105	Fine sand & clay (2 ft.)			
105	165	Clay & fine sand in layers			
165	180	Fine to medium sand with some large gravel			
180	195	Fine to medium with some large gravel (very loose)			
195	210	Large gravel & medium to fine sand			
210	225	medium to coarse sand			
225	240	Clay, rock layers & blue shale			

7 CONTRACTOR'S OR LANDOWNER'S CERTIFICATION: This water well was (1) constructed, (2) reconstructed, or (3) plugged under my jurisdiction and was completed on (mo/day/year) August 12, 1986 and this record is true to the best of my knowledge and belief. Kansas

Water Well Contractor's License No. 179 This Water Well Record was completed on (mo/day/yr) Sept. 12, 1986
 under the business name of Joe's Well Service, Inc. Cimarron, Ks. by (signature) 

INSTRUCTIONS: Use typewriter or ball point pen. PLEASE PRESS FIRMLY and PRINT clearly. Please fill in blanks, underline or circle the correct answers. Send top three copies to Kansas Department of Health and Environment, Office of Oil Field and Environmental Geology, Regulation and Permitting Section, Topeka, Kansas 66620-7500, Telephone: 913-862-9360. Send one to WATER WELL OWNER and retain one for your records.