

CIM 17

WATER WELL RECORD

Form WWC-5

KSA 82a-1212

1 LOCATION OF WATER WELL:	Fraction NW 1/4 SW 1/4 SW 1/4	Section Number 12	Township Number T 26 S	Range Number R 28 EW
---------------------------	----------------------------------	----------------------	---------------------------	-------------------------


Distance and direction from nearest town or city street address of well if located within city?

611 East Ave 'B'

2 WATER WELL OWNER: Pete Bogert

RR#, St. Address, Box #: Box 614
City, State, ZIP Code: Cimarron, KS 67835Board of Agriculture, Division of Water Resources
Application Number:

3 LOCATE WELL'S LOCATION WITH AN "X" IN SECTION BOX:

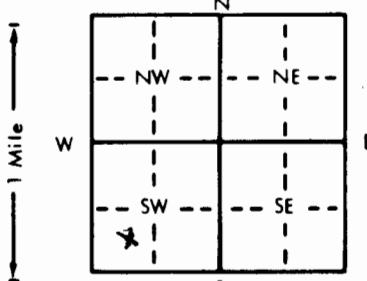

4 DEPTH OF COMPLETED WELL: ft. ELEVATION: ft.

Depth(s) Groundwater Encountered 1. ft. 2. ft. 3. ft.

WELL'S STATIC WATER LEVEL ft. below land surface measured on mo/day/yr

Pump test data: Well water was ft. after hours pumping gpm

Est. Yield gpm: Well water was ft. after hours pumping gpm

Bore Hole Diameter in. to ft. and in. to ft.

WELL WATER TO BE USED AS: 5 Public water supply 8 Air conditioning 11 Injection well

1 Domestic 3 Feedlot 6 Oil field water supply 9 Dewatering 12 Other (Specify below)

2 Irrigation 4 Industrial 7 Lawn and garden only 10 Observation well

Was a chemical/bacteriological sample submitted to Department? Yes. No. If yes, mo/day/yr sample was submitted

Water Well Disinfected? Yes No

5 TYPE OF BLANK CASING USED:

1 Steel 3 RMP (SR)
2 PVC 4 ABS

5 Wrought iron 8 Concrete tile Casing joints: Glued Clamped

6 Asbestos-Cement 9 Other (specify below) Welded

7 Fiberglass Threaded

Blank casing diameter in. to ft. Dia in. to ft. Dia in. to ft.

Casing height above land surface 14 in., weight lbs./ft. Wall thickness or gauge No. 40

TYPE OF SCREEN OR PERFORATION MATERIAL:

7 PVC 10 Asbestos-cement

8 RMP (SR) 11 Other (specify)

9 ABS 12 None used (open hole)

SCREEN OR PERFORATION OPENINGS ARE:

5 Gauzed wrapped 8 Saw cut 11 None (open hole)

6 Wire wrapped 9 Drilled holes

7 Torch cut 10 Other (specify)

SCREEN-PERFORATED INTERVALS: From ft. to ft. From ft. to ft.

From ft. to ft. From ft. to ft.

GRAVEL PACK INTERVALS: From ft. to ft. From ft. to ft.

From ft. to ft. From ft. to ft.

6 GROUT MATERIAL: 1 Neat cement 2 Cement grout 3 Bentonite 4 Other

Grout Intervals: From 0 ft. to 5 ft. From ft. to ft. From ft. to ft.

What is the nearest source of possible contamination:

10 Livestock pens 14 Abandoned water well

11 Fuel storage 15 Oil well/Gas well

12 Fertilizer storage 16 Other (specify below)

13 Insecticide storage

Direction from well? 0 How many feet? 0

FROM TO LITHOLOGIC LOG FROM TO LITHOLOGIC LOG

well had insufficient casing height

steel casing - added 14 inches PVC - cement grout from ground level

7 up PVC 5 inches - rubber seal around pipe (well seal)

0 14" PVC

7 CONTRACTOR'S OR LANDOWNER'S CERTIFICATION: This water well was (1) constructed, (2) reconstructed, or (3) plugged under my jurisdiction and was completed on (mo/day/year) 5-20-89 and this record is true to the best of my knowledge and belief. Kansas

Water Well Contractor's License No. 172 This Water Well Record was completed on (mo/day/yr) 5-25-89

under the business name of Tanagan Drilling by (signature) Pete Bogert