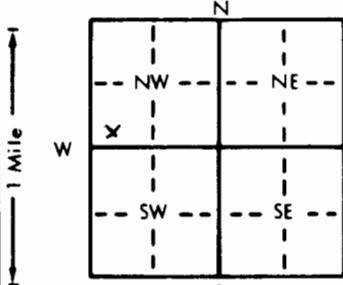


WATER WELL RECORD Form WWC-5 KSA 82a-1212

1 LOCATION OF WATER WELL: County: Gray		Fraction SW $\frac{1}{4}$ NW $\frac{1}{4}$ NW $\frac{1}{4}$	Section Number 12	Township Number T 26 S	Range Number R 28 EW
Distance and direction from nearest town or city street address of well if located within city? 400 ft North of East Ave A Reeves Addition Block 12 Lot 15					
2 WATER WELL OWNER: Mark Anderson RR#, St. Address, Box #: Box 593 City, State, ZIP Code: Cimarron, KS 67835		Board of Agriculture, Division of Water Resources Application Number: -0-			
3 LOCATE WELL'S LOCATION WITH AN "X" IN SECTION BOX: 		4 DEPTH OF COMPLETED WELL... 35 ft. ELEVATION: ft. Depth(s) Groundwater Encountered 1. 0 ft. 2. 0 ft. 3. 0 ft. WELL'S STATIC WATER LEVEL 0 ft. below land surface measured on mo/day/yr 6-14-90 Pump test data: Well water was ft. after hours pumping gpm Est. Yield gpm: Well water was ft. after hours pumping gpm Bore Hole Diameter in. to ft., and in. to ft. WELL WATER TO BE USED AS: 5 Public water supply 8 Air conditioning 11 Injection well 1 Domestic 3 Feedlot 6 Oil field water supply 9 Dewatering 12 Other (Specify below) 2 Irrigation 4 Industrial 7 Lawn and garden only 10 Monitoring well Was a chemical/bacteriological sample submitted to Department? Yes No If yes, mo/day/yr sample was submitted Water Well Disinfected? Yes No			
5 TYPE OF BLANK CASING USED: 1 Steel 3 RMP (SR) 2 PVC 4 ABS		5 Wrought iron 6 Asbestos-Cement 7 Fiberglass	8 Concrete tile 9 Other (specify below)	CASING JOINTS: Glued Clamped Welded Threaded	
Blank casing diameter 4 in. to ft., Dia in. to ft., Dia in. to ft.					
Casing height above land surface 16 in., weight		lbs./ft. Wall thickness or gauge No.			
TYPE OF SCREEN OR PERFORATION MATERIAL: 1 Steel 3 Stainless steel 2 Brass 4 Galvanized steel		5 Fiberglass 6 Concrete tile	7 PVC 8 RMP (SR) 9 ABS	10 Asbestos-cement 11 Other (specify) 12 None used (open hole)	
SCREEN OR PERFORATION OPENINGS ARE: 1 Continuous slot 3 Mill slot 2 Louvered shutter 4 Key punched		5 Gauzed wrapped 6 Wire wrapped 7 Torch cut	8 Saw cut 9 Drilled holes 10 Other (specify)	11 None (open hole)	
SCREEN-PERFORATED INTERVALS: From ft. to ft., From ft. to ft.					
GRAVEL PACK INTERVALS: From ft. to ft., From ft. to ft.					
6 GROUT MATERIAL: 1 Neat cement Grout Intervals: From ft. to ft., From ft. to ft., From ft. to ft.		2 Cement grout 3 Bentonite	4 Other		
What is the nearest source of possible contamination: 1 Septic tank 4 Lateral lines 2 Sewer lines 5 Cess pool 3 Watertight sewer lines 6 Seepage pit		7 Pit privy 8 Sewage lagoon 9 Feedyard	10 Livestock pens 11 Fuel storage 12 Fertilizer storage 13 Insecticide storage	14 Abandoned water well 15 Oil well/Gas well 16 Other (specify below)	
Direction from well?		How many feet? 450 ft South			
FROM	TO	LITHOLOGIC LOG		FROM	TO
0	5'	Bentonite			
5'	35'	Fill Sand			
Well was dry - no water					
7 CONTRACTOR'S OR LANDOWNER'S CERTIFICATION: This water well was (1) constructed, (2) reconstructed, or (3) plugged under my jurisdiction and was completed on (mo/day/year) 6-14-90 and this record is true to the best of my knowledge and belief. Kansas Water Well Contractor's License No. 179 This Water Well Record was completed on (mo/day/yr) 6-14-90, by (signature) <i>Larry Creek</i>					
INSTRUCTIONS: Use typewriter or ball point pen. PLEASE PRESS FIRMLY and PRINT clearly. Please fill in blanks, underline or circle the correct answers. Send top three copies to Kansas Department of Health and Environment, Bureau of Water, Topeka, Kansas 66620-7320. Telephone: 913-296-5545. Send one to WATER WELL OWNER and retain one for your records.					