

1 LOCATION OF WATER WELL:	Fraction	Section Number	Township Number	Range Number
County: <u>Gray</u>	<u>NW 1/4 NW 1/4 SW 1/4</u>	<u>13</u>	<u>T 26 S</u>	<u>R 28 E</u>

Distance and direction from nearest town or city street address of well if located within city?

From Cimarron 1/2 mile south on 23 Hwy. and 1/8 mile east.2 WATER WELL OWNER: Charlie Fouks

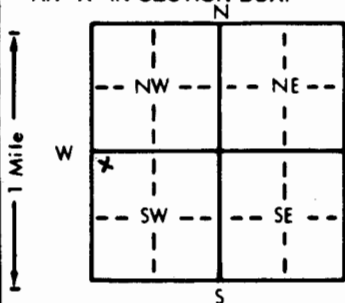
RR#, St. Address, Box # :

Board of Agriculture, Division of Water Resources

City, State, ZIP Code : Cimarron, Ks. 67835

Application Number:

3 LOCATE WELL'S LOCATION WITH AN "X" IN SECTION BOX:

4 DEPTH OF COMPLETED WELL: 177 1/2' ft. ELEVATION:

Depth(s) Groundwater Encountered 1. ft. 2. ft. 3. ft.

WELL'S STATIC WATER LEVEL: 75' ft. below land surface measured on mo/day/yr 4-7-92

Pump test data: Well water was ft. after hours pumping gpm

Est. Yield gpm: Well water was ft. after hours pumping gpm

Bore Hole Diameter: 9 7/8" in. to ft., and in. to ft.

WELL WATER TO BE USED AS:

<input checked="" type="checkbox"/> 1 Domestic	<input type="checkbox"/> 3 Feedlot	<input type="checkbox"/> 6 Oil field water supply	<input type="checkbox"/> 9 Dewatering	<input type="checkbox"/> 11 Injection well
<input type="checkbox"/> 2 Irrigation	<input type="checkbox"/> 4 Industrial	<input type="checkbox"/> 7 Lawn and garden only	<input type="checkbox"/> 10 Monitoring well	<input type="checkbox"/> 12 Other (Specify below)

Was a chemical/bacteriological sample submitted to Department? Yes No ☒ If yes, mo/day/yr sample was sub-

mitted

Water Well Disinfected? Yes ☒ No

5 TYPE OF BLANK CASING USED:

1 Steel	3 RMP (SR)	5 Wrought iron	8 Concrete tile	CASING JOINTS: Glued <input checked="" type="checkbox"/> Clamped
<input checked="" type="checkbox"/> 2 PVC	4 ABS	6 Asbestos-Cement	9 Other (specify below)	Welded
		7 Fiberglass		Threaded

Blank casing diameter: 5" in. to 157 1/2' ft., Dia. in. to ft., Dia. in. to ft.Casing height above land surface: 12" in., weight lbs./ft. Wall thickness or gauge No. SDR 21

TYPE OF SCREEN OR PERFORATION MATERIAL:

1 Steel	3 Stainless steel	5 Fiberglass	8 RMP (SR)	10 Asbestos-cement
2 Brass	4 Galvanized steel	6 Concrete tile	9 ABS	11 Other (specify)
				12 None used (open hole)

SCREEN OR PERFORATION OPENINGS ARE:

1 Continuous slot	3 Mill slot	5 Gauzed wrapped	<input checked="" type="checkbox"/> 8 Saw cut	11 None (open hole)
2 Louvered shutter	4 Key punched	6 Wire wrapped	9 Drilled holes	
		7 Torch cut	10 Other (specify)	

SCREEN-PERFORATED INTERVALS: From 157 1/2' ft. to 177 1/2' ft., From ft. to ft.

From ft. to ft., From ft. to ft.

GRAVEL PACK INTERVALS: From 24' ft. to 125' ft., From 130' ft. to 177 1/2' ft.

From ft. to ft., From ft. to ft.

6 GROUT MATERIAL:

1 Neat cement 2 Cement grout ☒ 3 Bentonite 4 OtherGrout Intervals: From 4' ft. to 24' ft., From 125' ft. to 130' ft., From ft. to ft.

What is the nearest source of possible contamination:

1 Septic tank	4 Lateral lines	7 Pit privy	10 Livestock pens	<input checked="" type="checkbox"/> 14 Abandoned water well
2 Sewer lines	5 Cess pool	8 Sewage lagoon	11 Fuel storage	15 Oil well/Gas well
3 Watertight sewer lines	6 Seepage pit	9 Feedyard	12 Fertilizer storage	16 Other (specify below)
			13 Insecticide storage	

Direction from well? WestHow many feet? 10'

FROM	TO	LITHOLOGIC LOG	FROM	TO	PLUGGING INTERVALS
0	5	Topsoil - Sandy clay mixed			
5	50	Fine to med. sand			
50	52	Brown Clay			
52	60	Caliche			
60	80	Fine to med. sand - sandrock layer			
80	98	Med. Sand			
98	102	Brown clay			
102	106	Fine to med. sand			
106	130	Fine sand & brown clay			
130	140	Brown clay sand mixed			
140	177	med. sand - shale			

7 CONTRACTOR'S OR LANDOWNER'S CERTIFICATION: This water well was ☒ (1) constructed, ☐ (2) reconstructed, or ☐ (3) plugged under my jurisdiction and wascompleted on (mo/day/year) 4-7-92 and this record is true to the best of my knowledge and belief. KansasWater Well Contractor's License No. 533 This Water Well Record was completed on (mo/day/yr) 5-23-92under the business name of Jantzen Water Well Repair by (signature) [Signature]