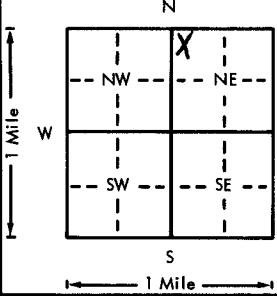
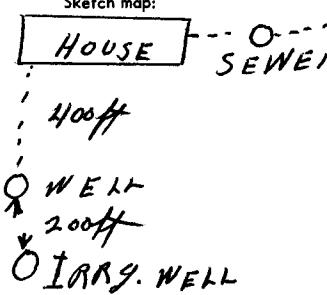


USE TYPEWRITER OR BALL
POINT PEN-PRESS FIRMLY,
PRINT CLEARLY.

WATER WELL RECORD
KSA 82a-1201-1215

Kansas Department of Health and
Environment-Division of Environment
(Water well Contractors)
Topeka, Kansas 66620

1. Location of well:	County	Fraction	Section number	Township number	Range number		
	Gray	NW 1/4 NW 1/4 NE 1/4	#14	T #26	S R #28 E <input checked="" type="checkbox"/>		
2. Distance and direction from nearest town or city: $\frac{1}{2}$ mile south on Highway 23 of Cimarron, Ks. Street address or well location if in city:	3. Owner of well: Paul Meadows R.R. or street: City, state, zip code: Cimarron, Kansas 67835						
4. Locate with "X" in section below: 	Sketch map: 						
5. Type and color of material	From	To	6. Bore hole dia. <u>8 1/2</u> in. Completion date <u>7-23-76</u> Well depth <u>155</u> ft.				
Topsoil & coarse sand	0	15	7. <input checked="" type="checkbox"/> Cable tool <input checked="" type="checkbox"/> Rotary <input type="checkbox"/> Driven <input type="checkbox"/> Dug <input type="checkbox"/> Hollow rod <input type="checkbox"/> Jetted <input type="checkbox"/> Bored <input type="checkbox"/> Reverse rotary				
Coarse sand & clay	15	30	8. Use: <input checked="" type="checkbox"/> Domestic <input type="checkbox"/> Public supply <input type="checkbox"/> Industry <input type="checkbox"/> Irrigation <input type="checkbox"/> Air conditioning <input type="checkbox"/> Stock <input type="checkbox"/> Lawn <input type="checkbox"/> Oil field water <input type="checkbox"/> Other				
Clay	30	45	9. Casing: Material <u>RMP</u> Height: Above or <u>below</u> Threaded <input type="checkbox"/> Welded <input type="checkbox"/> Surface <u>12</u> in. RMP <input checked="" type="checkbox"/> PVC <input type="checkbox"/> Weight <input type="checkbox"/> lbs./ft. Dia. <u>5</u> in. to <u>155</u> ft. depth Wall Thickness: inches or Dia. <input type="checkbox"/> in. to <input type="checkbox"/> ft. depth gage No. <u>250</u>				
Clay & white rock	45	60	10. Screen: Manufacturer's name <u>Sunflower</u> Type <u>RMP</u> Dia. <u>5"</u> Slot/gage <u>1/8"</u> Length <u>20ft.</u> Set between <u>130</u> ft. and <u>150</u> ft. ft. and <u>150</u> ft. Gravel pack? <u>yes</u> Size range of material <u>1"</u>				
Clay	60	90	11. Static water level: <u>78</u> ft. below land surface Date <u>7-23-76</u>				
Clay & fine sand	90	135	12. Pumping level below land surfaces: <u>78</u> ft. after <u>1</u> hrs. pumping <u>50</u> g.p.m. <input type="checkbox"/> ft. after <input type="checkbox"/> hrs. pumping <input type="checkbox"/> g.p.m. Estimated maximum yield <u>80</u> g.p.m.				
Medium to coarse sand	135	150	13. Water sample submitted: <u>Yes</u> <input checked="" type="checkbox"/> No Date <u>7-23-76</u>				
Coarse sand & clay	150	165	14. Well head completion: <u>212</u> Inches above grade <input checked="" type="checkbox"/> Pitless adapter				
			15. Well grouted? <u>yes</u> With: <input checked="" type="checkbox"/> Neat cement <input type="checkbox"/> Bentonite <input type="checkbox"/> Concrete Depth: From <u>7</u> ft. to <u>30</u> ft.				
			16. Nearest source of possible contamination: <u>Irrigation</u> ft. <u>200</u> Direction <u>South</u> Type <u>Pump & well</u> Well disinfected upon completion? <input checked="" type="checkbox"/> Yes <input type="checkbox"/> No				
			17. Pump: <input type="checkbox"/> Not installed Manufacturer's name <u>Flint & Walling</u> Model number <u>10BK9</u> HP <u>1</u> Volts <u>230</u> Length of drop pipe <u>147</u> ft. capacity <u>19</u> g.p.m. Type: <input checked="" type="checkbox"/> Submersible <input type="checkbox"/> Turbine <input type="checkbox"/> Jet <input type="checkbox"/> Reciprocating <input type="checkbox"/> Centrifugal <input type="checkbox"/> Other				
(Use a second sheet if needed)			18. Elevation: Topography: <input type="checkbox"/> Hill <input type="checkbox"/> Slope <input checked="" type="checkbox"/> Upland <input type="checkbox"/> Valley				
			19. Remarks: <p>Joe's Well Service 179 Business name <u>Box 174</u> Cimarron, Ks. Address <u>Laury Creek</u> Date <u>8-13-76</u> Signed <u>Laury Creek</u> Authorized representative </p>				
20. Water well contractor's certification: This well was drilled under my jurisdiction and this report is true to the best of my knowledge and belief.							