


1 LOCATION OF WATER WELL: County: Gray Fraction: SW 1/4 NW 1/4 NE 1/4 Section Number: 14 Township Number: T 26 S Range Number: R 28 E(W)

Distance and direction from nearest town or city street address of well if located within city?
K 23 - 1/2 mile South of Cimarron - Site Inventory No. 130

2 WATER WELL OWNER: Vernon Hanna
RR#, St. Address, Box #: Box 256 Board of Agriculture, Division of Water Resources
City, State, ZIP Code: Cimarron, Ks 67835 Application Number:

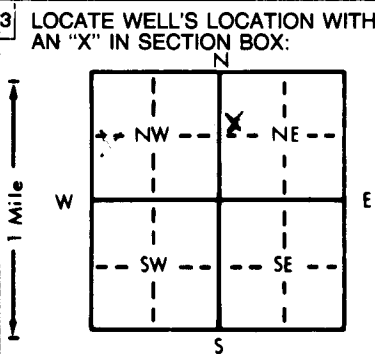

4 DEPTH OF COMPLETED WELL: 30 ft. ELEVATION:
Depth(s) Groundwater Encountered 1. ft. 2. ft. 3. ft.
WELL'S STATIC WATER LEVEL: 6 ft. below land surface measured on mo/day/yr 3-28-90
Pump test data: Well water was . ft. after . hours pumping . gpm
Est. Yield . gpm: Well water was . ft. after . hours pumping . gpm
Bore Hole Diameter . in. to . ft., and . in. to . ft.
WELL WATER TO BE USED AS:
1 Domestic 3 Feedlot 6 Oil field water supply 9 Dewatering 12 Other (Specify below)
2 Irrigation 4 Industrial 7 Lawn and garden only 10 Observation well
Was a chemical/bacteriological sample submitted to Department? Yes . No .; If yes, mo/day/yr sample was submitted .
Water Well Disinfected? Yes . No .

5 TYPE OF BLANK CASING USED:
1 Steel 3 RMP (SR) 5 Wrought iron 8 Concrete tile CASING JOINTS: Glued . Clamped .
2 PVC 4 ABS 6 Asbestos-Cement 9 Other (specify below) Welded .
7 Fiberglass Threaded .
Blank casing diameter . 16 . in. to . ft., Dia . in. to . ft., Dia . in. to . ft.
Casing height above land surface . 6 ft. below . in., weight . lbs./ft. Wall thickness or gauge No. .
TYPE OF SCREEN OR PERFORATION MATERIAL:
1 Steel 3 Stainless steel 5 Fiberglass 7 PVC 10 Asbestos-cement
2 Brass 4 Galvanized steel 6 Concrete tile 8 RMP (SR) 11 Other (specify) .
9 ABS 12 None used (open hole)
SCREEN OR PERFORATION OPENINGS ARE:
1 Continuous slot 3 Mill slot 5 Gauzed wrapped 8 Saw cut 11 None (open hole)
2 Louvered shutter 4 Key punched 6 Wire wrapped 9 Drilled holes
7 Torch cut 10 Other (specify) .
SCREEN-PERFORATED INTERVALS: From . ft. to . ft., From . ft. to . ft., From . ft. to . ft.
GRAVEL PACK INTERVALS: From . ft. to . ft., From . ft. to . ft., From . ft. to . ft.

6 GROUT MATERIAL: 1 Neat cement 2 Cement grout 3 Bentonite 4 Other
Grout intervals: From . ft. to . ft., From . ft. to . ft., From . ft. to . ft.
What is the nearest source of possible contamination:
1 Septic tank 4 Lateral lines 7 Pit privy 10 Livestock pens 14 Abandoned water well
2 Sewer lines 5 Cess pool 8 Sewage lagoon 11 Fuel storage 15 Oil well/Gas well
3 Watertight sewer lines 6 Seepage pit 9 Feedyard 12 Fertilizer storage 16 Other (specify below)
13 Insecticide storage
Direction from well? How many feet? 400

FROM	TO	LITHOLOGIC LOG	FROM	TO	LITHOLOGIC LOG
		Battery of 2 wells - South well had been filled thru the years - only 6ft. pit remained - filled pit with sand - put 6 inch cement cap on top of pit.			
		North well and pit open.			
0	2'	cement cap			
2'	6'	sand			
6'	8'	bentonite plug			
8'	30'	chlorinated sand			

7 CONTRACTOR'S OR LANDOWNER'S CERTIFICATION: This water well was (1) constructed, (2) reconstructed, or (3) plugged under my jurisdiction and was completed on (mo/day/year) 3-28-90 and this record is true to the best of my knowledge and belief. Kansas Water Well Contractor's License No. . This Water Well Record was completed on (mo/day/yr) . under the business name of . by (signature) Vernon Hanna

INSTRUCTIONS: Use typewriter or ball point pen. PLEASE PRESS FIRMLY and PRINT clearly. Please fill in blanks, underline or circle the correct answers. Send top three copies to Kansas Department of Health and Environment, Bureau of Water Protection, Topeka, Kansas 66620-7320, Telephone: 913-862-9360. Send one to WATER WELL OWNER and retain one for your records.