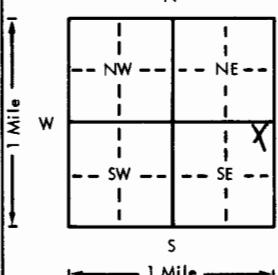
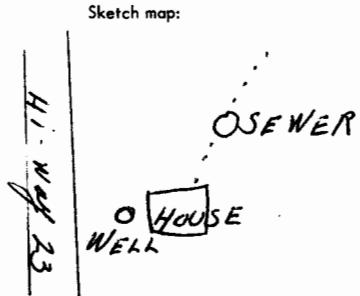
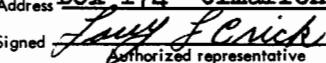


USE TYPEWRITER OR BALL  
POINT PEN-PRESS FIRMLY,  
PRINT CLEARLY.

WATER WELL RECORD  
KSA 82a-1201-1215

Kansas Department of Health and  
Environment-Division of Environment  
(Water well Contractors)  
Topeka, Kansas 66620

1. Location of well:	County Gray	Fraction NE 1/4 NE 1/4 SE 1/4	Section number #14	Township number T #26	Range number S R #28 W 1/4		
2. Distance and direction from nearest town or city: Cimarron, Ks, on highway 23 Street address or well location if in city:	3. Owner of well: Gary Smith R.R. or street: City, state, zip code: Cimarron, Kansas 67835						
4. Locate with "X" in section below:  	Sketch map:  						
5. Type and color of material	From	To	6. Bore hole dia. 8 in. Completion date 8-27-76 Well depth 215 ft.				
Top soil & coarse sand	0	15	7. <input checked="" type="checkbox"/> Cable tool <input type="checkbox"/> Rotary <input type="checkbox"/> Driven <input type="checkbox"/> Dug <input type="checkbox"/> Hollow rod <input type="checkbox"/> Jetted <input type="checkbox"/> Bored <input type="checkbox"/> Reverse rotary				
Coarse sand	15	30	8. Use: <input checked="" type="checkbox"/> Domestic <input type="checkbox"/> Public supply <input type="checkbox"/> Industry <input type="checkbox"/> Irrigation <input type="checkbox"/> Air conditioning <input type="checkbox"/> Stock <input type="checkbox"/> Lawn <input type="checkbox"/> Oil field water <input type="checkbox"/> Other				
Coarse sand & clay	30	45	9. Casing: Material RMP Height: Above or 8 ft. Threaded <input type="checkbox"/> Welded <input type="checkbox"/> Surface 12 in. RMP <input checked="" type="checkbox"/> PVC <input type="checkbox"/> Weight _____ lbs./ft. Dia. 5 in. to 215 ft. depth Wall thickness: inches or Dia. _____ in. to _____ ft. depth gage No. 250				
Medium sand & clay	45	60	10. Screen: Manufacturer's name Sunflower Type RMP Dia. 5" Slot size 1/8" Length 20 ft. Set between 190 ft. and 210 ft. ft. and _____ ft. Gravel pack? <input checked="" type="checkbox"/> Yes Size range of material 1/4"				
Clay	60	90	11. Static water level: 30 ft. below land surface Date 8-27-76 mo./day/yr.				
Clay & fine sand	90	105	12. Pumping level below land surfaces: 30 ft. after 1 hrs. pumping 70 g.p.m. ft. after _____ hrs. pumping _____ g.p.m. Estimated maximum yield 90 g.p.m.				
Fine sand & clay layers	105	120	13. Water sample submitted: mo./day/yr. Yes <input checked="" type="checkbox"/> No Date				
Clay	120	135	14. Well head completion: <input checked="" type="checkbox"/> Pitless adapter 12 inches above grade				
Clay & fine sand	135	150	15. Well grouted? <input checked="" type="checkbox"/> Yes With: <input checked="" type="checkbox"/> Neat cement <input type="checkbox"/> Bentonite <input type="checkbox"/> Concrete Depth: From 7 ft. to 20 ft.				
Clay & medium to coarse sand	150	165	16. Nearest source of possible contamination: ft. 110 Direction NE Type Sewer Well disinfected upon completion? <input checked="" type="checkbox"/> Yes <input type="checkbox"/> No				
Coarse sand	165	195	17. Pump: Not installed Manufacturer's name Flint & Walling Model number 10BK9 HP 10 Volts 230 Length of drop pipe 168 ft. capacity 19 g.p.m.				
Medium to coarse sand	195	210	Type: <input checked="" type="checkbox"/> Submersible <input type="checkbox"/> Turbine <input type="checkbox"/> Jet <input type="checkbox"/> Reciprocating <input type="checkbox"/> Centrifugal <input type="checkbox"/> Other				
Medium sand, clay & blue shale	210	225	18. Elevation:				
(Use a second sheet if needed)				19. Remarks: Has good drainage to the North and East			
Topography: <input type="checkbox"/> Hill <input checked="" type="checkbox"/> Slope <input type="checkbox"/> Upland <input type="checkbox"/> Valley				20. Water well contractor's certification: This well was drilled under my jurisdiction and this report is true to the best of my knowledge and belief. Joe's Well Service 179 Business name <input type="checkbox"/> License No. Address Box 174 Cimarron, Ks. Signed  Authorized representative D 10-6-76			