

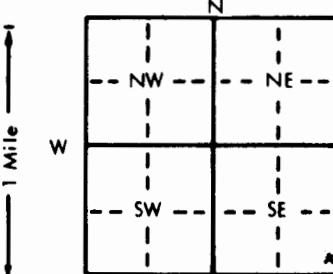
1 LOCATION OF WATER WELL:	Fraction County: <u>Gray</u> <u>SE 1/4</u> <u>SE 1/4</u> <u>SE 1/4</u>	Section Number 14	Township Number T 26 S	Range Number R 28 E
---------------------------	---	----------------------	---------------------------	------------------------

Distance and direction from nearest town or city street address of well if located within city?

From Cimarron 1 3/4 miles South on 23 Hwy.

2 WATER WELL OWNER: Collingwood

RR#, St. Address, Box # :

City, State, ZIP Code: Cimarron, KS 67835Board of Agriculture, Division of Water Resources
Application Number:3 LOCATE WELL'S LOCATION WITH AN "X" IN SECTION BOX:
N NE
W SW SE
S E 

4 DEPTH OF COMPLETED WELL..... <u>210'</u> ft. ELEVATION:
Depth(s) Groundwater Encountered 1..... ft. 2..... ft. 3..... ft.
WELL'S STATIC WATER LEVEL ... <u>55'</u> ft. below land surface measured on mo/day/yr
Pump test data: Well water was ft. after hours pumping gpm
Est. Yield gpm: Well water was ft. after hours pumping gpm
Bore Hole Diameter ... <u>9 7/8"</u> in. to ft., and in. to ft.
WELL WATER TO BE USED AS: 5 Public water supply 8 Air conditioning 11 Injection well 1 Domestic 3 Feedlot 6 Oil field water supply 9 Dewatering 12 Other (Specify below) 2 Irrigation 4 Industrial 7 Lawn and garden only 10 Monitoring well
Was a chemical/bacteriological sample submitted to Department? Yes..... No <input checked="" type="checkbox"/> ; If yes, mo/day/yr sample was submitted
Water Well Disinfected? Yes <input checked="" type="checkbox"/> No

5 TYPE OF BLANK CASING USED:	5 Wrought iron	8 Concrete tile	CASING JOINTS: Glued <input checked="" type="checkbox"/> Clamped
1 Steel	6 Asbestos-Cement	9 Other (specify below)	Welded
2 PVC <input checked="" type="checkbox"/>	7 Fiberglass		Threaded

Blank casing diameter 6 in. to 190' ft., Dia in. to ft., Dia in. to ft.Casing height above land surface. 12" in., weight

6 TYPE OF SCREEN OR PERFORATION MATERIAL:

1 Steel	3 Stainless steel	5 Fiberglass	8 RMP (SR)	10 Asbestos-cement
2 Brass	4 Galvanized steel	6 Concrete tile	9 ABS	11 Other (specify)
				12 None used (open hole)

SCREEN OR PERFORATION OPENINGS ARE:

1 Continuous slot	3 Mill slot	5 Gauzed wrapped	8 Saw cut	11 None (open hole)
2 Louvered shutter	4 Key punched	6 Wire wrapped	9 Drilled holes	
		7 Torch cut	10 Other (specify)	

SCREEN-PERFORATED INTERVALS: From 190' ft. to 210' ft., From ft. to ft.

From ft. to ft., From ft. to ft.

GRAVEL PACK INTERVALS: From 24' ft. to 210' ft., From ft. to ft.

From ft. to ft., From ft. to ft.

6 GROUT MATERIAL: 1 Neat cement 2 Cement grout 3 Bentonite 4 Other

Grout Intervals: From 4 ft. to 24' ft., From ft. to ft., From ft. to ft.

What is the nearest source of possible contamination:

1 Septic tank	4 Lateral lines	7 Pit privy	10 Livestock pens	14 Abandoned water well
2 Sewer lines <input checked="" type="checkbox"/>	5 Cess pool	8 Sewage lagoon	11 Fuel storage	15 Oil well/Gas well
3 Watertight sewer lines	6 Seepage pit	9 Feedyard	12 Fertilizer storage	16 Other (specify below)
			13 Insecticide storage	

Direction from well? Northwest How many feet? 150'

FROM	TO	LITHOLOGIC LOG	FROM	TO	PLUGGING INTERVALS
0	<u>19</u>	Sandy Topsoil			
<u>19</u>	<u>59</u>	Med. Course Sand			
<u>59</u>	<u>60</u>	Brown clay layer			
<u>60</u>	<u>79</u>	Med. Sand			
<u>79</u>	<u>90</u>	Fine to med. Sand + caliche			
<u>90</u>	<u>102</u>	med. Sand			
<u>102</u>	<u>114</u>	Brown clay			
<u>114</u>	<u>132</u>	Fine to med. Sand + brown clay layers			
<u>132</u>	<u>134</u>	Brown clay			
<u>134</u>	<u>138</u>	med. Sand			
<u>138</u>	<u>153</u>	Brown clay			
<u>153</u>	<u>170</u>	med. Sand brown clay layers			
<u>170</u>	<u>208</u>	med. Course Sand			
<u>208</u>	<u>220</u>	Yellow clay Fine sand mixed			

7 CONTRACTOR'S OR LANDOWNER'S CERTIFICATION: This water well was (1) constructed, (2) reconstructed, or (3) plugged under my jurisdiction and was completed on (mo/day/year) 12-14-91 and this record is true to the best of my knowledge and belief. KansasWater Well Contractor's License No. 533 This Water Well Record was completed on (mo/day/yr) 5-3-92 by (signature) Jantzen Water Well Repair