

WATER WELL RECORD Form WWC-5 KSA 82a-1212

1 LOCATION OF WATER WELL:	Fraction County: <i>Gray</i>	<i>NW 1/4 SW 1/4 SW 1/4</i>	Section Number 14	Township Number T 26 S	Range Number R 28 E
---------------------------	---------------------------------	-----------------------------	----------------------	---------------------------	------------------------

Distance and direction from nearest town or city street address of well if located within city?

From Cimarron 3/4 miles South


2 WATER WELL OWNER: *Forrest Jantzen*

RR#, St. Address, Box # : *Rt. 1*

City, State, ZIP Code : *Cimarron, KS 67835*

Board of Agriculture, Division of Water Resources
Application Number:

3 LOCATE WELL'S LOCATION WITH AN "X" IN SECTION BOX:

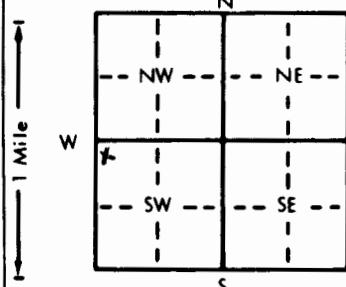

4 DEPTH OF COMPLETED WELL... *220'* ft. ELEVATION:

Depth(s) Groundwater Encountered 1. ft. 2. ft. 3. ft.

WELL'S STATIC WATER LEVEL ... *65'* ft. below land surface measured on mo/day/yr ... *1-14-92*

Pump test data: Well water was ft. after hours pumping gpm

Est. Yield gpm; Well water was ft. after hours pumping gpm

Bore Hole Diameter... *9 7/8"* in. to ft. and in. to ft.

WELL WATER TO BE USED AS: 5 Public water supply 8 Air conditioning 11 Injection well

1 Domestic 3 Feedlot 6 Oil field water supply 9 Dewatering 12 Other (Specify below)

2 Irrigation 4 Industrial 7 Lawn and garden only 10 Monitoring well

Was a chemical/bacteriological sample submitted to Department? Yes.....No. If yes, mo/day/yr sample was submitted

Water Well Disinfected? Yes No

5 TYPE OF BLANK CASING USED:

1 Steel 3 RMP (SR)
 2 PVC 4 ABS

5 Wrought iron 8 Concrete tile

6 Asbestos-Cement 9 Other (specify below)

CASING JOINTS: Glued Clamped

Welded

Threaded

Blank casing diameter ... *5"* in. to ... *200'* ft., Dia in. to ft., Dia in. to ft.

Casing height above land surface ... *12'* in., weight

lbs./ft. Wall thickness or gauge No. *SDR 21*

TYPE OF SCREEN OR PERFORATION MATERIAL:

1 Steel 3 Stainless steel 5 Fiberglass

2 Brass 4 Galvanized steel 6 Concrete tile

7 Fiberglass

8 RMP (SR) 9 ABS

10 Asbestos-cement

11 Other (specify)

12 None used (open hole)

13 Insecticide storage

14 Abandoned water well

15 Oil well/Gas well

16 Other (specify below)

SCREEN OR PERFORATION OPENINGS ARE:

1 Continuous slot 3 Mill slot 5 Gauzed wrapped

2 Louvered shutter 4 Key punched 6 Wire wrapped

7 Torch cut

8 Saw cut

9 Drilled holes

10 Other (specify)

SCREEN-PERFORATED INTERVALS: From. *200'* ft. to *220'* ft. From ft. to ft.

From. ft. to ft. From ft. to ft.

GRAVEL PACK INTERVALS: From. *24'* ft. to *131'* ft. From *136'* ft. to *220'* ft.

From ft. to ft. From ft. to ft.

6 GROUT MATERIAL: 1 Neat cement 2 Cement grout 3 Bentonite 4 Other

Grout Intervals: From ft. to ft., From ft. to ft., From ft. to ft.

What is the nearest source of possible contamination:

1 Septic tank 4 Lateral lines 7 Pit privy

2 Sewer lines 5 Cess pool 8 Sewage lagoon

3 Watertight sewer lines 6 Seepage pit 9 Feedyard

10 Livestock pens

11 Fuel storage

12 Fertilizer storage

13 Insecticide storage

14 Abandoned water well

15 Oil well/Gas well

16 Other (specify below)

Direction from well? *South east*

How many feet? *100'*

FROM TO LITHOLOGIC LOG FROM TO PLUGGING INTERVALS

<i>0</i>	<i>5</i>	<i>Sandy Topsoil</i>			
<i>5</i>	<i>40</i>	<i>Med. Sand</i>			
<i>40</i>	<i>80</i>	<i>med. Sand & Caliche</i>			
<i>80</i>	<i>100</i>	<i>Brown sandy clay</i>			
<i>100</i>	<i>140</i>	<i>med. Sand & brown clay layers</i>			
<i>140</i>	<i>167</i>	<i>Brown sandy clay</i>			
<i>167</i>	<i>220</i>	<i>Fine to med. sand</i>			
<i>220</i>	<i>230</i>	<i>Yellow clay & Shale</i>			

7 CONTRACTOR'S OR LANDOWNER'S CERTIFICATION: This water well was (1) constructed, (2) reconstructed, or (3) plugged under my jurisdiction and was completed on (mo/day/year) *1-14-92*

and this record is true to the best of my knowledge and belief. Kansas

Water Well Contractor's License No. *533*

This Water Well Record was completed on (mo/day/yr) *2-3-92*

under the business name of *Jantzen Water Well Repair* by (signature) *Ed Jantzen*

INSTRUCTIONS: Use typewriter or ball point pen. PLEASE PRESS FIRMLY and PRINT clearly. Please fill in blanks, underline or circle the correct answers. Send top three copies to Kansas Department of Health and Environment, Bureau of Water, Topeka, Kansas 66620-0001. Telephone: 913-296-5545. Send one to WATER WELL OWNER and retain one for your records.