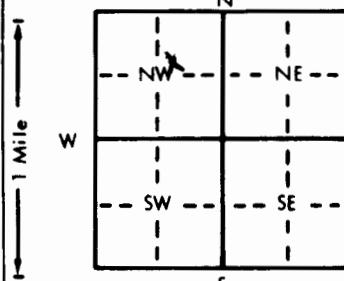


1 LOCATION OF WATER WELL:	Fraction County: <i>Gray</i>	Section Number <i>SW 1/4 NE 1/4 NW 1/4 16</i>	Township Number <i>T 26 S</i>	Range Number <i>R 28 E</i>
---------------------------	---------------------------------	--	----------------------------------	-------------------------------

Distance and direction from nearest town or city street address of well if located within city?

*From Cimarron South edge of Cimarron 1 3/4 miles west 1/4 south.*2 WATER WELL OWNER: *Wiley McFarland*RR#, St. Address, Box #: *Rt. 1* Board of Agriculture, Division of Water ResourcesCity, State, ZIP Code: *Cimarron, KS 67835* Application Number:3 LOCATE WELL'S LOCATION WITH AN "X" IN SECTION BOX:4 DEPTH OF COMPLETED WELL: *190* ft. ELEVATION: _____

Depth(s) Groundwater Encountered 1. ft. 2. ft. 3. ft.

WELL'S STATIC WATER LEVEL: *52'* ft. below land surface measured on mo/day/yr *12-4-91*

Pump test data: Well water was ft. after hours pumping gpm

Est. Yield gpm: Well water was ft. after hours pumping gpm

Bore Hole Diameter: *7 1/8"* in. to ft. and in. to ft.

WELL WATER TO BE USED AS: 5 Public water supply 8 Air conditioning 11 Injection well

Domestic 3 Feedlot 6 Oil field water supply 9 Dewatering 12 Other (Specify below)

2 Irrigation 4 Industrial 7 Lawn and garden only 10 Monitoring well

Was a chemical/bacteriological sample submitted to Department? Yes. No. If yes, mo/day/yr sample was submitted

Water Well Disinfected? Yes No

5 TYPE OF BLANK CASING USED:

1 Steel 3 RMP (SR) 5 Wrought iron 8 Concrete tile CASING JOINTS: Glued Clamped

2 PVC 4 ABS 6 Asbestos-Cement 9 Other (specify below) Welded

Blank casing diameter: *5"* in. to ft. Dia in. to ft. Dia in. to ft.Casing height above land surface: *12"* in., weight _____ lbs./ft. Wall thickness or gauge No. _____

TYPE OF SCREEN OR PERFORATION MATERIAL:

1 Steel 3 Stainless steel 5 Fiberglass 8 RMP (SR) 10 Asbestos-cement

2 Brass 4 Galvanized steel 6 Concrete tile 9 ABS 11 Other (specify) _____

SCREEN OR PERFORATION OPENINGS ARE: 5 Gauzed wrapped 12 None used (open hole) 11 None (open hole)

1 Continuous slot 3 Mill slot 6 Wire wrapped 8 Saw cut

2 Louvered shutter 4 Key punched 7 Torch cut 9 Drilled holes

SCREEN-PERFORATED INTERVALS: From: *170* ft. to *190* ft. From: _____ ft. to _____ ft.

From: _____ ft. to _____ ft. From: _____ ft. to _____ ft.

GRAVEL PACK INTERVALS: From: *24* ft. to *113* ft. From: *119* ft. to *190* ft.

From: _____ ft. to _____ ft. From: _____ ft. to _____ ft.

6 GROUT MATERIAL: 1 Neat cement 2 Cement grout 3 Bentonite 4 Other

Grout Intervals: From: *4* ft. to *24* ft. From: *113* ft. to *119* ft. From: _____ ft. to _____ ft.

What is the nearest source of possible contamination:

1 Septic tank 4 Lateral lines 7 Pit privy 10 Livestock pens 14 Abandoned water well

2 Sewer lines 5 Cess pool 8 Sewage lagoon 11 Fuel storage 15 Oil well/Gas well

3 Watertight sewer lines 6 Seepage pit 9 Feedyard 12 Fertilizer storage 16 Other (specify below)

10 Insecticide storage

How many feet?

Direction from well?

FROM	TO	LITHOLOGIC LOG	FROM	TO	PLUGGING INTERVALS
0	5	Sandy Topsoil			
5	20	Med. Sand			
20	62	Fine sand - brown Sand clay			
62	93	Fine sand brown clay layers			
93	105	Med. Sand - brown clay 10705			
105	113	Rock layer - brown clay			
113	119	Brown clay			
119	125	Med. Sand (loose)			
125	133	Brown clay			
133	145	Fine to med. sand clay layers			
145	160	Fine to med. sand			
160	190	Med - Course Sand (loose)			
190	200	Yellow clay - shale			

7 CONTRACTOR'S OR LANDOWNER'S CERTIFICATION: This water well was (1) constructed, (2) reconstructed, or (3) plugged under my jurisdiction and was completed on (mo/day/year) *12-4-91* and this record is true to the best of my knowledge and belief, KansasWater Well Contractor's License No. *533* This Water Well Record was completed on (mo/day/yr) *12-19-91*under the business name of *Tarleton Water Well Repair* by (signature) *[Signature]*