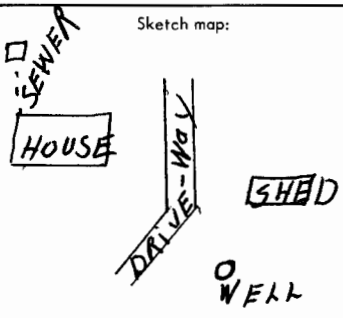


USE TYPEWRITER OR BALL POINT PEN-PRESS FIRMLY, PRINT CLEARLY.

WATER WELL RECORD
KSA 82a-1201-1215

Kansas Department of Health and Environment-Division of Environment
(Water well Contractors)
Topeka, Kansas 66620

1. Location of well:		County Gray	Fraction NW 1/4 NW 1/4 NE 1/4	Section number 20	Township number T 26 S R 28 E/W	Range number 28
2. Distance and direction from nearest town or city: 1 mile South & 3 miles West of Cimarron, Kansas Street address of well location if in city:				3. Owner of well: Alfred Smith Estate R.R. or street: City, state, zip code: Cimarron, Kansas 67835		
4. Locate with "X" in section below: N W E S 1 Mile		Sketch map: 			6. Bore hole dia. 205 ft. Completion date _____ Well depth 8 in. 7-30-78	
5. Type and color of material		From	To	7. <input type="checkbox"/> Cable tool <input checked="" type="checkbox"/> Rotary <input type="checkbox"/> Driven <input type="checkbox"/> Dug <input type="checkbox"/> Hollow rod <input type="checkbox"/> Jetted <input type="checkbox"/> Bored <input type="checkbox"/> Reverse rotary		
Top soil & fine sand		0	15	8. Use: <input checked="" type="checkbox"/> Domestic <input type="checkbox"/> Public supply <input type="checkbox"/> Industry <input type="checkbox"/> Irrigation <input type="checkbox"/> Air conditioning <input type="checkbox"/> Stock <input type="checkbox"/> Lawn <input type="checkbox"/> Oil field water <input type="checkbox"/> Other		
Medium to coarse sand		15	30	9. Casing: Material RMP Height: Above or below XX Threaded _____ Welded _____ Surface 12 in. RMP XX PVC _____ Weight _____ lbs./ft. Dia. 5 in. to 205 ft. depth Wall Thickness: _____ inches or Dia. _____ in. to _____ ft. depth Gauge No. 250		
Coarse sand		30	60	10. Screen: Manufacturer's name _____ Sunflower Type RMP Dia. 5" Slot 3/8" 1/8" Length 20 ft. Set between 180 ft. and 200 ft. _____ ft. and _____ ft. Gravel pack? yes Size range of material 1/4"		
Coarse sand (dry)		60	90	11. Static water level: _____ mo./day/yr. 74 ft. below land surface Date 7-30-78		
Coarse sand & clay layers		90	105	12. Pumping level below land surfaces: _____ ft. after _____ hrs. pumping _____ g.p.m. _____ ft. after _____ hrs. pumping _____ g.p.m. Estimated maximum yield 30 _____ g.p.m.		
Clay & fine sand		105	120	13. Water sample submitted: _____ mo./day/yr. <input type="checkbox"/> Yes <input checked="" type="checkbox"/> No Date _____		
Fine sand to medium sand		120	135	14. Well head completion: <input checked="" type="checkbox"/> Pitless adapter 12 inches above grade		
Fine sand & clay		135	150	15. Well grouted? yes With <input checked="" type="checkbox"/> Neat cement _____ Bentonite _____ Concrete _____ Depth: From 7 ft. to 20 ft.		
Clay		150	180	16. Nearest source of possible contamination: ft. 150 Direction NW Type Sewer Well disinfected upon completion? <input checked="" type="checkbox"/> Yes _____ No		
Clay & coarse sand (10 ft.)		180	195	17. Pump: <input checked="" type="checkbox"/> Not installed Manufacturer's name _____ Model number _____ HP _____ Volts _____ Length of drop pipe _____ ft. capacity _____ g.p.m. Type: <input type="checkbox"/> Submersible _____ Turbine _____ <input type="checkbox"/> Jet _____ Reciprocating _____ <input type="checkbox"/> Centrifugal _____ Other _____		
Coarse sand & clay		195	210	20. Water well contractor's certification: This well was drilled under my jurisdiction and this report is true to the best of my knowledge and belief. Joel's Well Service 179 Business name License No. Address Box 174 Cimarron, Ks. Signed Larry Chick 9-26-78 Authorized representative Date		
18. Elevation:		19. Remarks:		20. (Use a second sheet if needed)		
Topography: <input type="checkbox"/> Hill <input type="checkbox"/> Slope <input checked="" type="checkbox"/> Upland <input type="checkbox"/> Valley						

T 26 R 28 S 20 NW 1/4 NE

Forward the white, blue and pink copies to the Department of Health and Environment

Form WWC-5