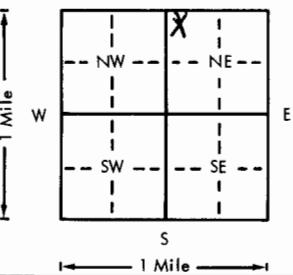
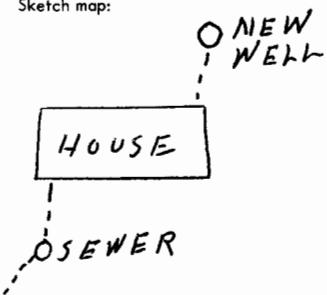


USE TYPEWRITER OR BALL  
POINT PEN-PRESS FIRMLY,  
PRINT CLEARLY.

WATER WELL RECORD  
KSA 82a-1201-1215

Kansas Department of Health and  
Environment-Division of Environment  
(Water well Contractors)  
Topeka, Kansas 66620

1. Location of well:	County	Fraction	Section number	Township number	Range number
Gray		NW 1/4 NW 1/4 NE 1/4	22	T 26	S R 28 EW
2. Distance and direction from nearest town or city: $1\frac{1}{2}$ mile south of Cimarron on highway 23 and $1\frac{1}{2}$ west Street address of well location if in city:			3. Owner of well: Bradley Koehn		
			R.R. or street: R.R.		
			City, state, zip code: Cimarron, Kansas 67835		
4. Locate with "X" in section below:	Sketch map:				
					
			6. Bore hole dia. 8 in. Completion date 3-1-77		
			Well depth 225 ft.		
			7. <input checked="" type="checkbox"/> Cable tool <input type="checkbox"/> Rotary <input type="checkbox"/> Driven <input type="checkbox"/> Dug <input type="checkbox"/> Hollow rod <input type="checkbox"/> Jetted <input type="checkbox"/> Bored <input type="checkbox"/> Reverse rotary		
			8. Use: <input checked="" type="checkbox"/> Domestic <input type="checkbox"/> Public supply <input type="checkbox"/> Industry <input type="checkbox"/> Irrigation <input type="checkbox"/> Air conditioning <input type="checkbox"/> Stock <input type="checkbox"/> Lawn <input type="checkbox"/> Oil field water <input type="checkbox"/> Other		
			9. Casing: Material RMP Height: Above or <input type="checkbox"/> 3000 Threaded <input type="checkbox"/> Welded <input type="checkbox"/> Surface 12 in. RMP <input checked="" type="checkbox"/> PVC Weight <input type="checkbox"/> lbs./ft. Dia. 5 in. to 225 ft. depth Wall Thickness: inches or Dia. <input type="checkbox"/> in. to <input type="checkbox"/> ft. depth Gage No. 250		
			10. Screen: Manufacturer's name Sunflower Type RMP Dia. 5" Slot <input type="checkbox"/> 1/8" Length 20 ft. Set between 200 ft. and 220 ft. ft. and <input type="checkbox"/> ft. Gravel pack? <input checked="" type="checkbox"/> yes Size range of material 1"		
			11. Static water level: 27 ft. below land surface Date 3-1-77		
			12. Pumping level below land surfaces: 27 ft. after 1 hrs. pumping 50 g.p.m. ft. after <input type="checkbox"/> hrs. pumping <input type="checkbox"/> g.p.m. Estimated maximum yield 70 g.p.m.		
			13. Water sample submitted: <input type="checkbox"/> Yes <input checked="" type="checkbox"/> No Date		
			14. Well head completion: <input checked="" type="checkbox"/> Pitless adapter 12 Inches above grade		
			15. Well grouted? <input checked="" type="checkbox"/> yes With: <input checked="" type="checkbox"/> Neat cement <input type="checkbox"/> Bentonite <input type="checkbox"/> Concrete Depth: From 7 ft. to 18 ft.		
			16. Nearest source of possible contamination: ft. 115 Direction south Type Sewer Well disinfected upon completion? <input checked="" type="checkbox"/> Yes <input type="checkbox"/> No		
			17. Pump: <input type="checkbox"/> Not installed Manufacturer's name Aermotor Model number SD19-100 HP 1 Volts 230 Length of drop pipe 147 ft. capacity 19 g.p.m. Type: <input checked="" type="checkbox"/> Submersible <input type="checkbox"/> Turbine <input type="checkbox"/> Jet <input type="checkbox"/> Reciprocating <input type="checkbox"/> Centrifugal <input type="checkbox"/> Other		
	(Use a second sheet if needed)		18. Elevation:	19. Remarks:	
Topography: <input type="checkbox"/> Hill <input checked="" type="checkbox"/> Slope <input checked="" type="checkbox"/> Upland <input type="checkbox"/> Valley			<p>This well was drilled under my jurisdiction and this report is true to the best of my knowledge and belief.</p> <p><b>Joe's Well Service 179</b> Business name <input type="checkbox"/> License No. Address Box 174 Cimarron, Ks. Signed <i>Paul L. Crick</i> Date 3-18-77 Authorized representative</p>		