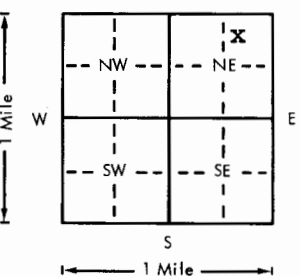


USE TYPEWRITER OR BALL
POINT PEN-PRESS FIRMLY,
PRINT CLEARLY.

WATER WELL RECORD
KSA 82a-1201-1215

Kansas Department of Health and
Environment-Division of Environment
(Water well Contractors)
Topeka, Kansas 66620

1. Location of well:		County Gray	Fraction NW 1/4 NE 1/4 NE 1/4	Section number 23	Township number T 26 S	Range number R 28 W E 1/4
2. Distance and direction from nearest town or city: 2 south of Cimarron, Ks.				3. Owner of well: Clarence Kerr		
Street address of well location if in city:				R.R. or street: Cimarron, Kansas 67835		
City, state, zip code:						
4. Locate with "X" in section below:		Sketch map:		6. Bore hole dia. 9 7/8 in. Completion date 4-07-78 Well depth 184 ft.		
				7. Cable tool <input checked="" type="checkbox"/> Rotary <input type="checkbox"/> Driven <input type="checkbox"/> Dug <input type="checkbox"/> Hollow rod <input type="checkbox"/> Jetted <input type="checkbox"/> Bored <input type="checkbox"/> Reverse rotary		
5. Type and color of material		From		To		8. Use: <input checked="" type="checkbox"/> Domestic <input type="checkbox"/> Public supply <input type="checkbox"/> Industry <input type="checkbox"/> Irrigation <input type="checkbox"/> Air conditioning <input type="checkbox"/> Stock <input type="checkbox"/> Lawn <input type="checkbox"/> Oil field water <input type="checkbox"/> Other
Med. to lar. sand & gravel		0		103		9. Casing: Material PVC Height: Above or below Threaded <input type="checkbox"/> Welded <input checked="" type="checkbox"/> Surface 12 in. RMP <input type="checkbox"/> PVC <input checked="" type="checkbox"/> Weight 2.77 lbs./ft. Dia. 5 in. to 184 ft. depth Wall Thickness: inches or Dia. <input type="checkbox"/> in. to <input type="checkbox"/> ft. depth gage No. 2.58
Med. to lar. sand with white clay		103		190		10. Screen: Manufacturer's name Pumpco Type PVC Dia. 5" Slot/groove .20 Length 40' Set between 144 ft. and 184 ft. ft. and <input type="checkbox"/> ft. Gravel pack? Yes Size range of material 1/64-5/32
						11. Static water level: 43 ft. below land surface Date 4-4-78 mo./day/yr.
						12. Pumping level below land surfaces: ft. after <input type="checkbox"/> hrs. pumping <input type="checkbox"/> g.p.m. ft. after <input type="checkbox"/> hrs. pumping <input type="checkbox"/> g.p.m. Estimated maximum yield 100 g.p.m.
						13. Water sample submitted: <input type="checkbox"/> Yes <input checked="" type="checkbox"/> No Date <input type="checkbox"/> mo./day/yr.
						14. Well head completion: XX Pitless adapter Unit <input type="checkbox"/> Inches above grade
						15. Well grouted? Yes With: <input checked="" type="checkbox"/> Neat cement <input type="checkbox"/> Bentonite <input type="checkbox"/> Concrete Depth: From 4 ft. to 14 ft.
						16. Nearest source of possible contamination: ft. 10 Direction west Type old well Well disinfected upon completion? XX Yes <input type="checkbox"/> No
						17. Pump: <input type="checkbox"/> Not installed Manufacturer's name Aermotor Model number SD19 HP 1 Volts 220 Length of drop pipe 80 ft. capacity 20 g.p.m. Type: <input checked="" type="checkbox"/> Submersible <input type="checkbox"/> Turbine <input type="checkbox"/> Jet <input type="checkbox"/> Reciprocating <input type="checkbox"/> Centrifugal <input type="checkbox"/> Other
18. Elevation:		19. Remarks:		20. Water well contractor's certification: This well was drilled under my jurisdiction and this report is true to the best of my knowledge and belief. Friesen Windmill 252 Business name License No. Address Meade, Kansas 67864 Signed John F. Friesen Date 4-12-78 Authorized representative		
Topography: <input type="checkbox"/> Hill <input type="checkbox"/> Slope <input checked="" type="checkbox"/> Upland <input type="checkbox"/> Valley		#16 Old well not plugged.				