


1 LOCATION OF WATER WELL: County: GRAY	Fraction SE 1/4 SE 1/4 SW 1/4	Section Number 23	Township Number T 26 S	Range Number R 28 EW
---	----------------------------------	----------------------	---------------------------	-------------------------

Distance and direction from nearest town or city street address of well if located within city?

3 MILES SOUTH OF CIMARRON

2 WATER WELL OWNER: GERALD HERR RR#, St. Address, Box # : CIMARRON, KS. City, State, ZIP Code :	Board of Agriculture, Division of Water Resources Application Number:
---	--

3 LOCATE WELL'S LOCATION WITH AN "X" IN SECTION BOX:	4 DEPTH OF COMPLETED WELL: 185 ft. ELEVATION:
--	---

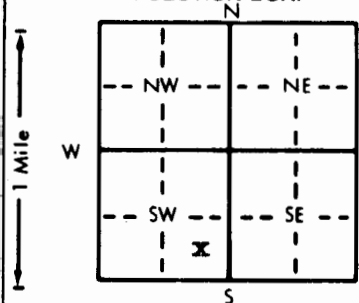

Depth(s) Groundwater Encountered 1. .... ft. 2. .... ft. 3. .... ft.

WELL'S STATIC WATER LEVEL .. 38 ... ft. below land surface measured on mo/day/yr ... 6/3/88

Pump test data: Well water was .... ft. after .... hours pumping .... gpm

Est. Yield .... gpm: Well water was .... ft. after .... hours pumping .... gpm

Bore Hole Diameter .. 9. 7/8 in. to ... 185 ... ft., and ... in. to ... ft.

WELL WATER TO BE USED AS: 5 Public water supply 8 Air conditioning 11 Injection well

☒ Domestic 3 Feedlot 6 Oil field water supply 9 Dewatering 12 Other (Specify below)

2 Irrigation 4 Industrial 7 Lawn and garden only 10 Monitoring well

Was a chemical/bacteriological sample submitted to Department? Yes.....No.. ☒ .....; If yes, mo/day/yr sample was submitted

Water Well Disinfected? Yes ☒ No

5 TYPE OF BLANK CASING USED:	5 Wrought iron	8 Concrete tile	CASING JOINTS: Glued <input checked="" type="checkbox"/> Clamped
1 Steel	3 RMP (SR)	6 Asbestos-Cement	9 Other (specify below)
<input checked="" type="checkbox"/> PVC	4 ABS	7 Fiberglass	10 Asbestos-cement
			11 Other (specify)
			12 None used (open hole)

Blank casing diameter .... 5 ... in. to ... 165 ... ft., Dia ... in. to ... ft., Dia ... in. to ... ft.

Casing height above land surface .. 18 ... in., weight ... 200 ... lbs./ft. Wall thickness or gauge No. ....

TYPE OF SCREEN OR PERFORATION MATERIAL:	<input checked="" type="checkbox"/> PVC	10 Asbestos-cement
1 Steel	3 Stainless steel	5 Fiberglass
2 Brass	4 Galvanized steel	6 Concrete tile
		8 RMP (SR)
		9 ABS
		11 Other (specify)
		12 None used (open hole)

SCREEN OR PERFORATION OPENINGS ARE:	5 Gauzed wrapped	8 Saw cut	11 None (open hole)
1 Continuous slot	<input checked="" type="checkbox"/> Mill slot	6 Wire wrapped	9 Drilled holes
2 Louvered shutter	4 Key punched	7 Torch cut	10 Other (specify)

SCREEN-PERFORATED INTERVALS: From ... 165 ... ft. to ... 185 ... ft., From ... ft. to ... ft.

From ... ft. to ... ft., From ... ft. to ... ft.

GRAVEL PACK INTERVALS: From ... 50 ... ft. to ... 185 ... ft., From ... ft. to ... ft.

From ... ft. to ... ft., From ... ft. to ... ft.

6 GROUT MATERIAL:	1 Neat cement	2 Cement grout	<input checked="" type="checkbox"/> Bentonite	4 Other
-------------------	---------------	----------------	---	---------

Grout Intervals: From ... 4 ... ft. to ... 30 ... ft., From ... ft. to ... ft., From ... ft. to ... ft.

What is the nearest source of possible contamination:	10 Livestock pens	14 Abandoned water well
<input checked="" type="checkbox"/> Septic tank	11 Fuel storage	15 Oil well/Gas well
2 Sewer lines	12 Fertilizer storage	16 Other (specify below)
3 Watertight sewer lines	13 Insecticide storage	
4 Lateral lines		
5 Cess pool		
6 Seepage pit		
7 Pit privy		
8 Sewage lagoon		
9 Feedyard		

Direction from well? north

How many feet? 100

FROM	TO	LITHOLOGIC LOG	FROM	TO	PLUGGING INTERVALS
0	41	FINE SAND			
41	55	BROWN SANDY CLAY			
55	75	FINE TO MED SAND AND GRAVEL			
75	96	BROWN SANDY CLAY			
96	100	FINE SAND TO MED SAND			
100	104	BROWN SANDY CLAY			
104	110	FINE TO MED SAND AND GRAVEL			
110	115	BROWN SANDY CLAY			
115	151	FINE TO MED SAND AND GRAVEL			
151	170	LIQUID SANDY CLAY			
170	185	FINE TO MED SAND AND GRAVEL			

7 CONTRACTOR'S OR LANDOWNER'S CERTIFICATION: This water well was <input checked="" type="checkbox"/> constructed, (2) reconstructed, or (3) plugged under my jurisdiction and was completed on (mo/day/year) .. 6/10/88 .. and this record is true to the best of my knowledge and belief. Kansas Water Well Contractor's License No. .... 172 .... This Water Well Record was completed on (mo/day/yr) 6/88 .. under the business name of JONAGAN DRILLING CO. by (signature) <i>[Signature]</i>
---