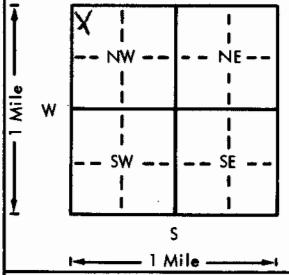
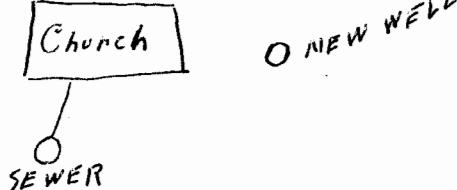


Sent to Leonard  
5-15-78

USE TYPEWRITER OR BALL  
POINT PEN-PRESS FIRMLY,  
PRINT CLEARLY.

WATER WELL RECORD  
KSA 82a-1201-1215

Kansas Department of Health and  
Environment-Division of Environment  
(Water well Contractors)  
Topeka, Kansas 66620

| 1. Location of well:   | County  | Fraction             | Section number   | Township number | Range number |
|--|---|----------------------|--|-----------------|--------------|
|  | Gray  | NW 1/4 NW 1/4 NW 1/4 | #24  | T #26           | S R #28 NW   |
| 2. Distance and direction from nearest town or city: 2 miles south of Cimarron, Ks.  | 3. Owner of well: Church of God in Christ Mennonite                               |                      |  |                 |              |
| Street address of well location if in city:  | R.R. or street: City, state, zip code: Cimarron, Kansas 67835                     |                      |  |                 |              |
| 4. Locate with "X" in section below:   | Sketch map:   |                      |  |                 |              |
|    |  |                      |  |                 |              |
| 5. Type and color of material  | From  | To                   | 6. Bore hole dia. 8 in. Completion date 8-15-75<br>Well depth 220 ft.  |                 |              |
| Top soil & coarse sand   | 0   | 15                   | 7. <input type="checkbox"/> Cable tool <input checked="" type="checkbox"/> Rotary <input type="checkbox"/> Driven <input type="checkbox"/> Dug<br><input type="checkbox"/> Hollow rod <input type="checkbox"/> Jetted <input type="checkbox"/> Bored <input type="checkbox"/> Reverse rotary   |                 |              |
| Coarse sand  | 15  | 30                   | 8. Use: <input type="checkbox"/> Domestic <input checked="" type="checkbox"/> Public supply <input type="checkbox"/> Industry<br><input type="checkbox"/> Irrigation <input type="checkbox"/> Air conditioning <input type="checkbox"/> Stock<br><input type="checkbox"/> Lawn <input type="checkbox"/> Oil field water <input type="checkbox"/> Other                             |                 |              |
| Medium sand  | 30  | 60                   | 9. Casing: Material RMP Height: Above ground 0 ft.<br>Threaded <input type="checkbox"/> Welded <input type="checkbox"/> Surface 12 in.<br>RMP <input checked="" type="checkbox"/> PVC Weight _____ lbs./ft.<br>Dia. 5 in. to 220 ft. depth Wall Thickness: inches or<br>Dia. _____ in. to _____ ft. depth gage No. 250   |                 |              |
| Medium to coarse sand  | 60  | 75                   | 10. Screen: Manufacturer's name Sunflower<br>Type RMP Dia. 5" 66/gauze 1/8" Length 20 ft.<br>Set between 195 ft. and 215 ft.<br>ft. and _____ ft.<br>Gravel pack? <input checked="" type="checkbox"/> Yes Size range of material 1/4 in.   |                 |              |
| Coarse sand & clay   | 75  | 90                   | 11. Static water level: 45 ft. below land surface Date 8-15-75<br>mo./day/yr.  |                 |              |
| Clay   | 90  | 105                  | 12. Pumping level below land surfaces:<br>50 ft. after 15 hrs. pumping 50 g.p.m.<br>ft. after _____ hrs. pumping _____ g.p.m.<br>Estimated maximum yield 50 g.p.m.   |                 |              |
| Clay & fine sand   | 105   | 120                  | 13. Water sample submitted: mo./day/yr.<br>Yes <input checked="" type="checkbox"/> No Date _____   |                 |              |
| Fine sand  | 120   | 135                  | 14. Well head completion:<br><input checked="" type="checkbox"/> Pitless adapter 12 inches above grade   |                 |              |
| Fine sand & clay   | 135   | 150                  | 15. Well grouted? <input checked="" type="checkbox"/> yes<br>With: <input checked="" type="checkbox"/> Neat cement <input type="checkbox"/> Bentonite <input type="checkbox"/> Concrete<br>Depth: From 5 ft. to 25 ft.   |                 |              |
| Medium sand  | 150   | 165                  | 16. Nearest source of possible contamination:<br>ft. 100 Direction SW Type Sewer<br>Well disinfected upon completion? <input checked="" type="checkbox"/> Yes <input type="checkbox"/> No  |                 |              |
| Medium-coarse sand   | 165   | 180                  | 17. Pump:<br>Manufacturer's name Flint & Walling<br>Model number 5BA8 HP 1/2 Volt 230<br>Length of drop pipe 105 ft. capacity 10 g.p.m.<br>Type:<br><input checked="" type="checkbox"/> Submersible <input type="checkbox"/> Turbine<br><input type="checkbox"/> Jet <input type="checkbox"/> Reciprocating<br><input type="checkbox"/> Centrifugal <input type="checkbox"/> Other |                 |              |
| Coarse sand  | 180   | 225                  | 18. Elevation: 19. Remarks:<br>Topography:<br><input type="checkbox"/> Hill<br><input type="checkbox"/> Slope<br><input checked="" type="checkbox"/> Upland<br><input type="checkbox"/> Valley   |                 |              |
| (Use a second sheet if needed)   |   |                      |  |                 |              |
| 20. Water well contractor's certification:<br>This well was drilled under my jurisdiction and this report<br>is true to the best of my knowledge and belief.<br>JOE'S WELL SERVICE 179<br>Business name Box 174 Cimarron, Ks. License No.<br>Address<br>Signed <u>Larry Crick</u> Date 12-20-75<br>Authorized representative |   |                      |  |                 |              |