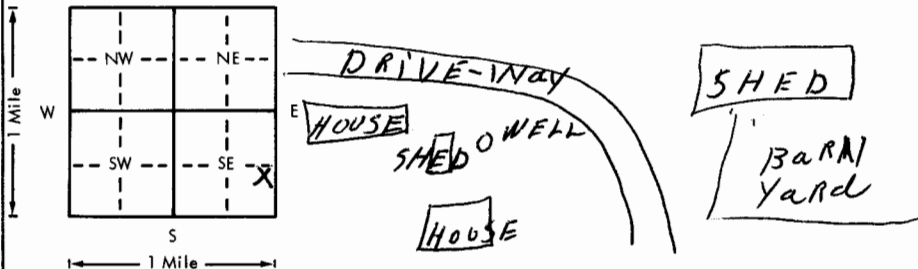


USE TYPEWRITER OR BALL
POINT PEN-PRESS FIRMLY,
PRINT CLEARLY.

WATER WELL RECORD
KSA 82a-1201-1215

Kansas Department of Health and
Environment-Division of Environment
(Water well Contractors)
Topeka, Kansas 66620

1. Location of well:		County Gray	Fraction NE SE SE 1/4 NE 1/4 SE 1/4	Section number 26	Township number T 26	Range number S R 28
2. Distance and direction from nearest town or city: 3 miles south on Highway 23 of Cimarron, Ks. Street address of well location if in city:			3. Owner of well: John Ratzliff R.R. or street: R. R. City, state, zip code: Cimarron, Kansas 67835			
4. Locate with "X" in section below: N W S 1 Mile 1 Mile			Sketch map: 			
5. Type and color of material			From	To	6. Bore hole dia. 8 in. Completion date 3-3-77 Well depth 220 ft.	
Top soil & fine sand			0	15	7. <input checked="" type="checkbox"/> Cable tool <input checked="" type="checkbox"/> Rotary <input type="checkbox"/> Driven <input type="checkbox"/> Dug <input type="checkbox"/> Hollow rod <input type="checkbox"/> Jetted <input type="checkbox"/> Bored <input type="checkbox"/> Reverse rotary	
Fine sand & clay			15	30	8. Use: <input checked="" type="checkbox"/> Domestic <input type="checkbox"/> Public supply <input type="checkbox"/> Industry <input type="checkbox"/> Irrigation <input type="checkbox"/> Air conditioning <input type="checkbox"/> Stock <input type="checkbox"/> Lawn <input type="checkbox"/> Oil field water <input type="checkbox"/> Other	
Clay			30	45	9. Casing: Material RMP Height: Above or XXX Threaded <input type="checkbox"/> Welded <input type="checkbox"/> Surface 12 in. RMP XX PVC <input type="checkbox"/> Weight <input type="checkbox"/> lbs./ft. Dia. 5 in. to 220 ft. depth Wall Thickness: inches or Dia. <input type="checkbox"/> in. to <input type="checkbox"/> ft. depth gage No. 250	
Clay & medium sand			45	60	10. Screen: Manufacturer's name Sunflower Type RMP Dia. 5 " Slot 1/8 " Length 20 ft. Set between 200 ft. and 220 ft. ft. and <input type="checkbox"/> ft. Gravel pack? yes Size range of material 4 "	
Coarse sand			60	120	11. Static water level: <input type="checkbox"/> mo./day/yr. 75 ft. below land surface Date 3-3-77	
Coarse sand & clay			120	135	12. Pumping level below land surfaces: 80 ft. after 1 hrs. pumping 50 g.p.m. ft. after <input type="checkbox"/> hrs. pumping <input type="checkbox"/> g.p.m. Estimated maximum yield 75 g.p.m.	
Clay			135	150	13. Water sample submitted: <input type="checkbox"/> Yes <input checked="" type="checkbox"/> No Date <input type="checkbox"/>	
Clay & fine sand layers			150	180	14. Well head completion: <input checked="" type="checkbox"/> Pitless adapter 12 inches above grade	
Clay & fine sand layers, coarse sand (2ft.)			180	195	15. Well grouted? yes With: <input checked="" type="checkbox"/> Neat cement <input type="checkbox"/> Bentonite <input type="checkbox"/> Concrete Depth: From 8 ft. to 20 ft.	
Coarse sand			195	215	16. Nearest source of possible contamination: Barn ft. 70 Direction West Type yard Well disinfected upon completion? <input checked="" type="checkbox"/> Yes <input type="checkbox"/> No	
Coarse sand, coarse clay & blue shale			215	225	17. Pump: <input checked="" type="checkbox"/> Not installed Manufacturer's name <input type="checkbox"/> Model number <input type="checkbox"/> HP <input type="checkbox"/> Volts <input type="checkbox"/> Length of drop pipe <input type="checkbox"/> ft. capacity <input type="checkbox"/> g.p.m. Type: <input type="checkbox"/> Submersible <input type="checkbox"/> Turbine <input type="checkbox"/> Jet <input type="checkbox"/> Reciprocating <input type="checkbox"/> Centrifugal <input type="checkbox"/> Other	
(Use a second sheet if needed)						
18. Elevation:		19. Remarks: Has good drainage to the West.		20. Water well contractor's certification: This well was drilled under my jurisdiction and this report is true to the best of my knowledge and belief. JOE'S WELL SERVICE 179 Business name License No. Address Box 174 Cimarron, Ks. Signed Larry C. Crick Date <input type="checkbox"/> Authorized representative		

Forward the white, blue and pink copies to the Department of Health and Environment

Form WWC-5