

USE TYPEWRITER OR BALL POINT PEN-PRESS FIRMLY, PRINT CLEARLY.

WATER WELL RECORD  
KSA 82a-1201-1215


T R EW sec 1/4 1/4 1/4 No.

Kansas State Dept. Of Health  
(Water Well Contractors)  
Forbes-Bldg. 740  
Topeka, Kansas 66620

1 Location of well:	County <b>Gray</b>	Township name <b>Cimarron</b>	Fraction <b>SE 1/4 of NE 1/4</b>	Section number <b>36</b>	Town number <b>T-26-S</b>	Range number <b>R-28-W</b>
---------------------	-----------------------	----------------------------------	-------------------------------------	-----------------------------	------------------------------	-------------------------------

Distance and direction from nearest town or city:  
**4 mi. south and 1/2 east of Cimarron**  
Street address of well location if in city:

3 Owner of well: **Larry Addison**  
Address: **Cimarron, Kansas**

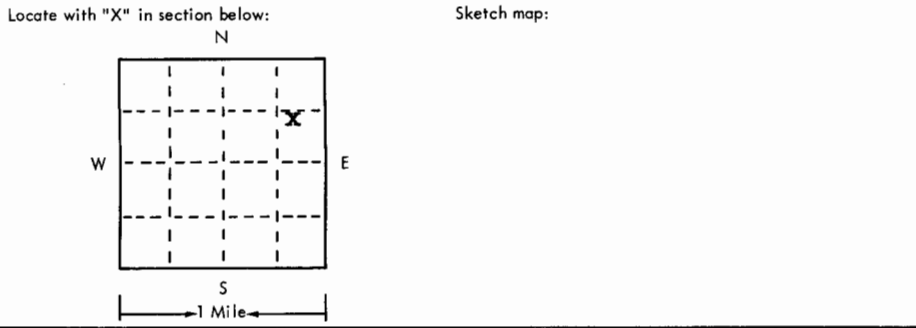

4 Well depth: **260** ft. Date of completion **9-6-75**  
Well diameter **26** in.

5  Cable tool  Rotary  Driven  Dug  
 Hollow rod  Jetted  Bored  Reverse rotary

6 Use:  Domestic  Public supply  Industry  
 Irrigation  Air conditioning  Commercial  
 Test well

7 Casing: Material **Meta** Height: above/below  
Threaded  Welded  Surface **12** in.  
Diam. **16** in. to **260** ft. depth Drive shoe?  Yes  No  
Weight **30.30** lbs./ft. —

2 Type and color of material	From	To
Surface	0	3
Fine sand	3	37
Fine sand and some clay	37	39
Med. sand and gravel	39	45
Fine sand with 10% clay mixed	45	55
A-1 sand and gravel	55	105
Clay	105	107
Good sand and gravel	107	135
Caleche sandy clay	135	142
Med. sand & fine gravel with 15% clay	142	157
50% clay-50% fine sand	157	180
A-1 sand & flat water gravel	180	255
Clay	255	259
(use a second sheet if needed)		

8 Screen: **W.A. Brown-Free-flo**  
Manufacturer **Free-flo** Dia. **16"**  
Type **Free-flo** Slot/gauze **1/8** Length **2"**  
Set between **60** ft. and **140** ft. **180 to 260**  
Fittings: Gravel pack  Yes  No Size range of material **CMA 3/8**

9 Static water level: **NA**  
\_\_\_\_\_ ft. below land surface Date \_\_\_\_\_

10 Pumping level below land surfaces: **NA**  
\_\_\_\_\_ ft. after \_\_\_\_\_ hrs. pumping \_\_\_\_\_ g.p.m.  
\_\_\_\_\_ ft. after \_\_\_\_\_ hrs. pumping \_\_\_\_\_ g.p.m.  
Estimated maximum yield \_\_\_\_\_ g.p.m.

11 Water sample submitted:  
 Yes  No Date \_\_\_\_\_

12 Well head completion:  
 Pitless adapter  Inches above grade

13 Well grouted?  Yes  No  
 Neat cement  Bentonite  \_\_\_\_\_  
Depth: From **0** ft. to **10** ft.

14 Nearest source of possible contamination: **NA**  
ft. \_\_\_\_\_ Direction \_\_\_\_\_ Type \_\_\_\_\_  
Well disinfected upon completion?  Yes  No

15 Pump:  Not installed  
Manufacturer's name **Simmons**  
Model number **S-1100HP 100** Volts \_\_\_\_\_  
Length of drop pipe **140** ft. capacity **800** g.m.p.  
Type:  
 Submersible  Turbine  
 Jet  Reciprocating  
 Centrifugal  Other

16 Remarks: elevation

Topography:  
 Hill  
 Slope  
 Upland  
 Valley

17 Water well contractor's certification:  
This well was drilled under my jurisdiction and this report is true to the best of my knowledge and belief.

**Ace-Hi International Inc.** 190  
Business name License No. \_\_\_\_\_  
Address **Box 1442, Dodge City, Ks**  
Signed **Carl C. Antel** Date **8-22-75**  
Authorized representative