

CORRECTION(S) TO WATER WELL RECORD (WWC-5)

(to rectify lacking or incorrect information)

County: Gray

Location listed as:

Location changed to:

Section-Township-Range: 6-265-28W

6-265-28W

Fraction ($\frac{1}{4}$ $\frac{1}{4}$ $\frac{1}{4}$): lot 6

NE NW SW

Other changes: Initial statements: _____

Changed to: _____

Comments: _____

verification method: Written & legal descriptions, position on plat map,
and Ingalls 1:24,000 topo. map.

initials: DRJ date: 10/27/2003

submitted by: Kansas Geological Survey, Data Resources Library, 1930 Constant Ave., Lawrence, KS 66047-3726
to: Kansas Dept of Health & Environment, Bureau of Water, 1000 SW Jackson, Suite 420, Topeka, KS 66612-1367.

WATER WELL RECORD Form WWC-5 KSA 82a-1212

1 LOCATION OF WATER WELL: COUNTY: 035 GRAY FRACTION LOT 6 1/4 SECTION NUMBER 06 TOWNSHIP NUMBER T 26 RANGE NUMBER R 28 W

DISTANCE AND DIRECTION FROM NEAREST TOWN OR CITY STREET ADDRESS OF WELL IF LOCATED WITHIN CITY?
FROM INGALLS; APPX 1 MILE EAST & 3/4 MILE SOUTH


2 WATER WELL OWNER: JIM AST
RR#, St. Address, Box #: 13503 OLD HWY 50

1 well of Battery of 3 wells
BOARD OF AGRICULTURE, DIVISION OF WATER RESOURCES

CITY, STATE, ZIP CODE : CIMARRON, KS 67835-

APPLICATION NUMBER: 10521

3 LOCATE WELL'S LOCATION WITH AN "X" IN SECTION BOX:

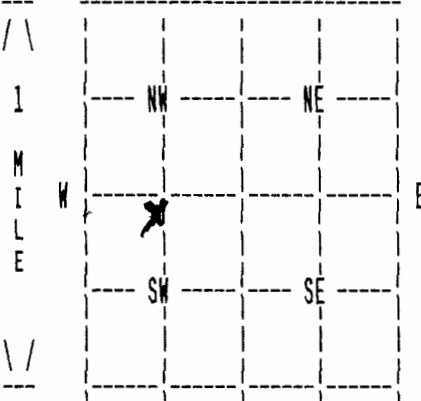

4 DEPTH OF COMPLETED WELL 143 ELEVATION: 0
DEPTH(S) GROUNDWATER ENCOUNTERED 1. 0 FT. 2. 0 FT. 3. 0 FT.

WELL'S STATIC WATER LEVEL 19 FT. BELOW LAND SURFACE MEASURED ON MO/DAY/YR 03/27/03
PUMP TEST DATA: WELL WATER WAS 67 FT. AFTER 4 HOURS PUMPING 500 GPM

ESTIMATED YIELD 0 GPM: WELL WATER WAS 0 FT. AFTER 0 HOURS PUMPING 0 GPM

BORE HOLE DIAMETER 24 IN. TO 143 FT., AND IN. TO 0 FT.

WELL WATER TO BE USED AS: 02 IRRIGATION

WAS A CHEMICAL/BACTERIOLOGICAL SAMPLE SUBMITTED TO DEPARTMENT? No ;
IF YES, MO/DAY/YR SAMPLE WAS SUBMITTED WATER WELL DISINFECTED? YES

5 TYPE OF BLANK CASING USED: 02 PVC

CASING JOINTS: GLUED

BLANK CASING DIAMETER 16 IN. TO 143 FT., DIA IN. TO 0 FT., DIA IN. TO 0 FT.

CASING HEIGHT ABOVE LAND SURFACE 12 IN. WEIGHT 16 LBS/FT. WALL THICKNESS OR GAUGE NO. .500

TYPE OF SCREEN OR PERFORATION MATERIAL: 03 STAINLESS STEEL

SCREEN OR PERFORATION OPENINGS ARE: 01 CONT. SLOT

SCREEN PERFORATED INTERVALS: FROM 43 FT. TO 123 FT., FROM 0 FT. TO 0 FT.

FROM 0 FT. TO 0 FT., FROM 0 FT. TO 0 FT.

GRAVEL PACK INTERVALS: FROM 20 FT. TO 143 FT., FROM 0 FT. TO 0 FT.

FROM 0 FT. TO 0 FT., FROM 0 FT. TO 0 FT.

6 GROUT MATERIAL 03 BENTONITE

GROUT INTERVALS: FROM 0 FT. TO 20 FT., FROM 0 FT. TO 0 FT., FROM 0 FT. TO 0 FT.

WHAT IS THE NEAREST SOURCE OF POSSIBLE CONTAMINATION: 14 ABAND. WELL

DIRECTION FROM WELL? NORTHWEST

HOW MANY FEET? 27

FROM	TO	LITHOLOGIC LOG	FROM	TO	PLUGGING INTERVALS
0	2	02 SILT			
2	6	04 SANDY CLAY			
6	70	05 SAND 11 GRAVEL			
70	86	04 SANDY CLAY			
86	95	07 FINE SAND 08 MEDIUM SAND			
95	123	05 SAND			
123	135	01 CLAY 20 LIMESTONE			
135	140	19 SHALE			

7 CONTRACTOR'S OR LANDOWNER'S CERTIFICATION: THIS WATER WELL WAS CONSTRUCTED UNDER MY JURISDICTION AND WAS COMPLETED ON (MO/DAY/YEAR) 03/25/03 AND THIS RECORD IS TRUE TO THE BEST OF MY KNOWLEDGE AND BELIEF. KANSAS

WATER WELL CONTRACTOR'S LICENSE NO. 145

UNDER THE BUSINESS NAME OF HENKLE DRILLING & SUPPLY

THIS WATER WELL RECORD WAS COMPLETED ON (MO/DAY/YR) 06/06/03

BY (SIGNATURE)

Bruno R. R. R.