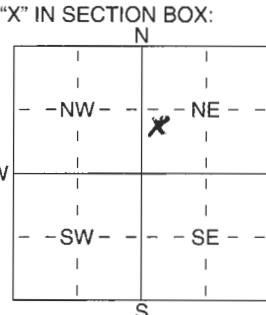


1 LOCATION OF WATER WELL:	Fraction	Section Number	Township Number	Range Number
County: <u>Gray</u>	<u>NW 1/4 SW 1/4 NE 1/4</u>	<u>14</u>	T <u>26</u> S	R <u>28</u> E/NO

Distance and direction from nearest town or city street address of well if located within city?

From Cimarron, 3/8 mile south on 17th Rd2 WATER WELL OWNER: Bob UnruhRR#, St. Address, Box # : P.O. Box 516City, State, ZIP Code : Cimarron, KS 67835Board of Agriculture, Division of Water Resources
Application Number: _____3 LOCATE WELL'S LOCATION WITH AN "X" IN SECTION BOX: 4 DEPTH OF COMPLETED WELL 150 ft. ELEVATION: _____

Depth(s) Groundwater Encountered 1 ft. 2 ft. 3 ft.
WELL'S STATIC WATER LEVEL 90 ft. below land surface measured on mo/day/yr 5-23-04
Pump test data: Well water was ft. after hours pumping gpm
Est. Yield gpm: Well water was ft. after hours pumping gpm
WELL WATER TO BE USED AS: 5 Public water supply 8 Air conditioning 11 Injection well
① Domestic 3 Feedlot 6 Oil field water supply 9 Dewatering 12 Other (Specify below)
2 Irrigation 4 Industrial 7 Domestic (lawn & garden) 10 Monitoring well

Was a chemical/bacteriological sample submitted to Department? Yes No ; If yes, mo/day/yr sample was submitted
Water Well Disinfected? Yes No

5 TYPE OF BLANK CASING USED: 5 Wrought iron 8 Concrete tile CASING JOINTS: Glued Clamped
1 Steel 3 RMP (SR) 6 Asbestos-Cement Welded
② PVC 4 ABS 7 Fiberglass Threaded
Blank casing diameter 5 in. to 130 ft. Dia in. to ft. Dia in. to ft.Casing height above land surface 12 in., weight lbs./ft. Wall thickness or guage No. SD.6.21TYPE OF SCREEN OR PERFORATION MATERIAL: ⑦ PVC 10 Asbestos-Cement
1 Steel 3 Stainless Steel 8 RMP (SR) 11 Other (Specify)
2 Brass 4 Galvanized Steel 6 Concrete tile 9 ABS 12 None used (open hole)SCREEN OR PERFORATION OPENINGS ARE: 5 Guazed wrapped ⑧ Saw cut 11 None (open hole)
1 Continuous slot 3 Mill slot 6 Wire wrapped 9 Drilled holes
2 Louvered shutter 4 Key punched 7 Torch cut 10 Other (specify) ft.SCREEN-PERFORATED INTERVALS: From 130 ft. to 150 ft., From ft. to ft.
From ft. to ft., From ft. to ft.GRAVEL PACK INTERVALS: From 24 ft. to 100 ft., From 110 ft. to 150 ft., From ft. to ft.6 GROUT MATERIAL: 1 Neat cement 2 Cement grout ③ Bentonite 4 Other
Grout Intervals: From 4 ft. to 24 ft., From 100 ft. to 110 ft., From ft. to ft.What is the nearest source of possible contamination: ⑩ Livestock pens 14 Abandoned water well
1 Septic tank 4 Lateral lines 7 Pit privy 11 Fuel storage 15 Oil well/Gas well
2 Sewer lines 5 Cess pool 8 Sewage lagoon 12 Fertilizer storage 16 Other (specify below)
3 Watertight sewer lines 6 Seepage pit 9 Feedyard 13 Insecticide storageDirection from well? East How many feet? 65

FROM	TO	LITHOLOGIC LOG	FROM	TO	PLUGGING INTERVALS
0	2	Topsoil			
2	15	Course Sand			
15	40	Brown sandy clay			
40	90	white rock			
90	110	Brown clay			
110	150	Med. sand			

RECEIVED

OCT 11 2004

BUREAU OF WATER

7 CONTRACTOR'S OR LANDOWNER'S CERTIFICATION: This water well was constructed, (2) reconstructed, or (3) plugged under my jurisdiction and was completed on (mo/day/year) 5-23-04 and this record is true to the best of my knowledge and belief. KansasWater Well Contractor's Licence No. 533 This Water Well Record was completed on (mo/day/year) 10-6-04 by (signature) _____under the business name of Tan Taa Water Well Repair

INSTRUCTIONS: Use typewriter or ball point pen. PLEASE PRESS FIRMLY and PRINT clearly. Please fill in blanks, underline or circle the correct answers. Send top three copies to Kansas Department of Health and Environment, Bureau of Water, Geology Section, 1000 SW Jackson St., Suite 420, Topeka, Kansas 66612-1367. Telephone 785-296-5522. Send one to WATER WELL OWNER and retain one for your records. Fee of \$5.00 for each constructed well.