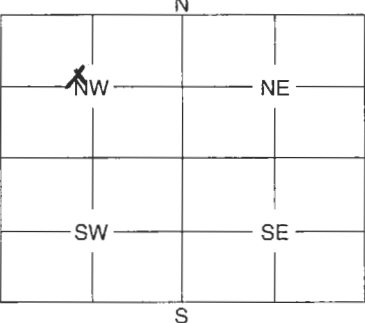


1	LOCATION OF WATER WELL:	Fraction <u>SE SE NW</u> 1/4 1/4 1/4	Section Number <u>6</u>	Township Number <u>26</u>	Range Number <u>28</u> <b>EW</b>
County: <u>Graham</u>					

Distance and direction from nearest town or city street address of well if located within city?

From Ingalls, 1 1/2 miles east on Hwy. 50

2	WATER WELL OWNER: <u>Rachel O'Neal</u>	Board of Agriculture, Division of Water Resources
RR #, St. Address, Box #: <u>P.O. Box 665</u>		Application Number:
City, State, ZIP Code: <u>Cimarron, KS. 67825</u>		

3	MARK WELL'S LOCATION WITH AN "X" IN SECTION BOX:	4	DEPTH OF WELL ..... <u>53</u> ..... ft. WELL'S STATIC WATER LEVEL ..... ft. WELL WAS USED AS: <input checked="" type="checkbox"/> 1 Domestic <input type="checkbox"/> 2 Irrigation <input type="checkbox"/> 3 Feedlot <input type="checkbox"/> 4 Industrial <input type="checkbox"/> 5 Public Water Supply <input type="checkbox"/> 6 Oil Field Water Supply <input type="checkbox"/> 7 Domestic (Lawn & Garden) <input type="checkbox"/> 8 Air Conditioning <input type="checkbox"/> 9 Dewatering <input type="checkbox"/> 10 Monitoring Well <input type="checkbox"/> 11 Injection Well <input type="checkbox"/> 12 Other .....
		Was a chemical / bacteriological sample submitted to Department? Yes ..... No <u>X</u> ..... If yes, mo/day/yr sample was submitted ..... Water Well Disinfected: Yes ..... No .....	

5	TYPE OF BLANK CASING USED:
<input checked="" type="checkbox"/> 1 Steel    3 RMP (SR)    5 Wrought    7 Fiberglass    9 Other (Specify below) <input type="checkbox"/> 2 PVC    4 ABS    6 Asbestos-Cement    8 Concrete Tile	
Blank casing diameter ..... <u>4</u> ..... in.    Was casing pulled?    Yes .....    No <u>X</u> .....    If yes, how much ..... Casing height above or below land surface ..... <u>36</u> ..... in.	

6	GROUT PLUG MATERIAL:    1 Neat cement    2 Cement grout <input checked="" type="checkbox"/> 3 Bentonite    4 Other .....
Grout Plug Intervals:    From ..... <u>3</u> ..... ft.    to ..... <u>53</u> ..... ft.,    From ..... ft.    to ..... ft.,    From ..... to ..... ft.	
What is the nearest source of possible contamination: 1 Septic tank    6 Seepage pit    11 Fuel storage    16 Other (specify below) <u>In pasture</u> 2 Sewer lines    7 Pit privy    12 Fertilizer storage 3 Watertight sewer lines    8 Sewage lagoon    13 Insecticide storage 4 Lateral lines    9 Feedyard    14 Abandoned water well 5 Cess pool    10 Livestock pens    15 Oil well/Gas well	
Direction from well? .....    How many feet? .....	

FROM	TO	PLUGGING MATERIALS
<u>3</u>	<u>53</u>	<u>Bentonite chips</u>
<u>23</u>	<u>53</u>	<u>Compacted clays</u>

RECEIVED

OCT 11 2004

BUREAU OF WATER

7	CONTRACTOR'S OF LANDOWNER'S CERTIFICATION: This water well was plugged under my jurisdiction and was completed on (mo/day/year) ..... <u>5-8-04</u> ..... and this record is true to the best of my knowledge and belief. Kansas Water Well Contractor's License No. <u>532</u> ..... This Water Well Record was completed on (mo/day/year) ..... <u>10-6-04</u> ..... under the business name of <u>Jantzen Water Well Repair</u> by (signature) <u>[Signature]</u>
---	--

INSTRUCTIONS: Use typewriter or ball point pen. Please press firmly and print clearly. Please fill in blanks, underline or circle the correct answers. Send top three copies to Kansas Department of Health and Environment, Bureau of Water, Geology Section, 1000 SW Jackson St., Ste. 420, Topeka, Kansas 66612-1367. Telephone: 785/296-5522. Send one to Water Well Owner and retain one for your records.