


WATER WELL RECORD Form WWC-5 KSA 82a-1212

1 LOCATION OF WATER WELL: COUNTY: 035 GRAY Fraction NE 1/4 NW 1/4 SW 1/4 Section Number 06 Township Number T 26 S Range Number R 28 W

Distance and direction from nearest town or city street address of well if located within city? APPROX. 1 MILE EAST, 1/2 SOUTH AND 1/4 EAST OF INGALLS

2 WATER WELL OWNER: AST, JIM RR#, St. Address, Box #: 13503 OLD HWY 50 City, State, ZIP code: CIMARRON, KS 67835-8843 Board of Agriculture, Division of Water Resources Application Number: 10521

3 LOCATE WELL'S LOCATION WITH AN "X" IN SECTION BOX:

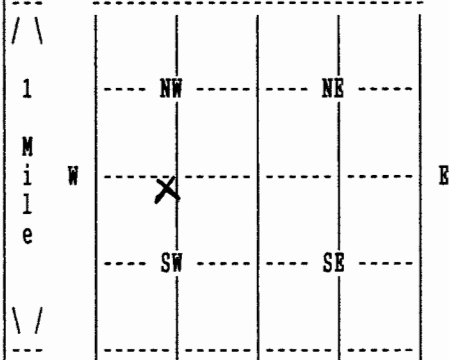

4 DEPTH OF COMPLETED WELL 25 ELEVATION: 0 Depth(s) Groundwater Encountered 1. 0 ft. 2. 0 ft. 3. 0 ft.

WELL'S STATIC WATER LEVEL 0 ft. below land surface measured on mo/day/yr Pump test data: Well water was 0 ft. after 0 hours pumping 0 gpm

Estimated Yield 0 gpm: Well water was 0 ft. after 0 hours pumping 0 gpm

Bore Hole Diameter in. to 0 ft., and in. to 0 ft.

WELL WATER WAS: 02 IRRIGATION

Was a chemical/bacteriological sample submitted to department? No; If yes, mo/day/yr sample was submitted Water well disinfected? Yes

5 TYPE OF BLANK CASING USED: 01 STEEL CASING JOINTS: WELDED Blank casing diameter 16 in. to 25 ft., Dia in. to 0 ft., Dia in. to 0 ft. Casing height above land surface -48 in., weight 0 lbs/ft. Wall thickness or gauge No. TYPE OF SCREEN OR PERFORATION MATERIAL: 01 STEEL SCREEN OR PERFORATION OPENINGS ARE: UNKNOWN

SCREEN PERFORATED INTERVALS: From 0 ft. to 0 ft., From 0 ft. to 0 ft. GRAVEL PACK INTERVALS: From 0 ft. to 0 ft., From 0 ft. to 0 ft.

6 GROUT MATERIAL 02 CEMENT GROUT Grout Intervals: From 4 ft. to 25 ft., From 0 ft. to 0 ft., From 0 ft. to 0 ft. What is the nearest source of possible contamination: 14 ABAND. WELL Direction from well? NORTH How many feet? 9

Table with columns: FROM, TO, LITHOLOGIC LOG, FROM, TO, PLUGGING INTERVALS. Includes BACKFILL CEMENT.

7 CONTRACTOR'S OR LANDOWNER'S CERTIFICATION: This water well was Plugged under my jurisdiction and was completed on (mo/day/year) 10/08/04 and this record is true to the best of my knowledge and belief. Kansas Water Well Contractor's License No. 145 This Water Well Record was completed on (mo/day/yr) 11/30/04 under the business name of HENKLE DRILLING & SUPPLY by (signature) [Signature]