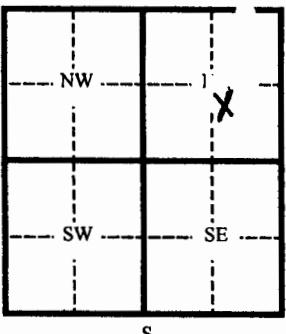


## WATER WELL PLUGGING RECORD

Form WWC-5P

KSA 82a-1212

ID No. **MW - 5**

1 LOCATION OF WATER WELL:		Fraction County: <b>Gray</b> NE      NW $\frac{1}{4}$ SE $\frac{1}{4}$ NE $\frac{1}{4}$	Section Number 11	Township Number 26	Range Number 28																																				
Distance and direction from nearest town or city street address of well if located within city?	
2 WATER WELL OWNER: <b>Grasser Oil</b>	
RR#, St. Address, Box # City, State, ZIP Code : <b>Cimarron, Ks 67835</b>			Board of Agriculture, Division of Water Resources Application Number:																																						
3 MARK WELL'S LOCATON WITH AN "X" IN SECTION BOX:		4 DEPTH OF WELL ..... <b>45</b> ft. WELL'S STATIC WATER LEVEL ..... ft. WELL WAS USED AS: <table> <tr><td>1 Domestic</td><td>5 Public Water Supply</td><td>9 Dewatering</td></tr> <tr><td>2 Irrigation</td><td>6 Oil Field Water Supply</td><td>10 Monitoring Well</td></tr> <tr><td>3 Feedlot</td><td>7 Lawn and Garden (domestic)</td><td>11 Injection Well</td></tr> <tr><td>4 Industrial</td><td>8 Air Conditioning</td><td>12 Other</td></tr> </table>				1 Domestic	5 Public Water Supply	9 Dewatering	2 Irrigation	6 Oil Field Water Supply	10 Monitoring Well	3 Feedlot	7 Lawn and Garden (domestic)	11 Injection Well	4 Industrial	8 Air Conditioning	12 Other																								
1 Domestic	5 Public Water Supply	9 Dewatering																																							
2 Irrigation	6 Oil Field Water Supply	10 Monitoring Well																																							
3 Feedlot	7 Lawn and Garden (domestic)	11 Injection Well																																							
4 Industrial	8 Air Conditioning	12 Other																																							
		Was a chemical/bacteriological sample submitted to Department? Yes ..... No ..... If yes, mo/day/yr sample was submitted ..... Water Well Disinfected: Yes ..... No ..... 																																							
5 TYPE OF BLANK CASING USED:	
1 Steel      3 RMP (SR)      5 Wrought      7 Fiberglass      9 Other (specify below) <input checked="" type="checkbox"/> 2 PVC      4 ABC      6 Asbestos-Cement      8 Concrete Tile Blank casing diameter <b>2</b> in.      Was casing pulled? Yes ..... No ..... If yes, how much ..... Casing height above or below land surface <b>-36</b> in.	
6 GROUT PLUG MATERIAL: 1 Neat cement      2 Cement grout      3 Bentonite      4 Other	
Grout Plug Intervals      From ..... ft. to ..... ft.      From ..... ft. to ..... ft.      From ..... ft. to ..... ft.	
What is the nearest source of possible contamination:	
1 Septic tank      6 Seepage pit      11 Fuel storage      16 Other (specify below) 2 Sewer lines      7 Pit privy      12 Fertilizer storage 3 Watertight sewer lines      8 Sewage lagoon      13 Insecticide storage 4 Lateral lines      9 Feedyard      14 Abandoned water well 5 Cess Pool      10 Livestock pens      15 Oil well/ Gas well	
Direction from well? ..... How many feet? .....	
<table border="1"> <thead> <tr> <th>FROM</th> <th>TO</th> <th>CODE</th> <th>PLUGGING MATERIALS</th> </tr> </thead> <tbody> <tr><td><b>45</b></td><td><b>3</b></td><td></td><td><b>Benonite</b></td></tr> <tr><td><b>3</b></td><td><b>.5</b></td><td></td><td><b>topsoil</b></td></tr> <tr><td><b>.5</b></td><td><b>0</b></td><td></td><td><b>cement</b></td></tr> <tr><td> </td><td> </td><td> </td><td> </td></tr> </tbody> </table>						FROM	TO	CODE	PLUGGING MATERIALS	<b>45</b>	<b>3</b>		<b>Benonite</b>	<b>3</b>	<b>.5</b>		<b>topsoil</b>	<b>.5</b>	<b>0</b>		<b>cement</b>																				
FROM	TO	CODE	PLUGGING MATERIALS																																						
<b>45</b>	<b>3</b>		<b>Benonite</b>																																						
<b>3</b>	<b>.5</b>		<b>topsoil</b>																																						
<b>.5</b>	<b>0</b>		<b>cement</b>																																						
7 CONTRACTOR'S OR LANDOWNER'S CERTIFICATION: This water well was plugged under my jurisdiction and was completed on (mo/day/yr) <b>4-13-05</b> and this record is true to the best of my knowledge and belief. Kansas Water Well Contractor's License No. <b>554</b> This Water Well Record was completed on (mo/day/yr) <b>5-13-05</b> under the business name of <b>Woolter Pump &amp; Well Inc.</b> by (signature) <i>Ray C. Woolter</i>	
INSTRUCTIONS: Please fill in blanks and circle the correct answers. Send three copies to Kansas Department of Health and Environment, Bureau of Water, 1000 S W Jackson St., Ste. 420, Topeka, Kansas 66620-0001. Telephone: 785-296-3565. Send one to Water Well Owner and retain one for your records.	