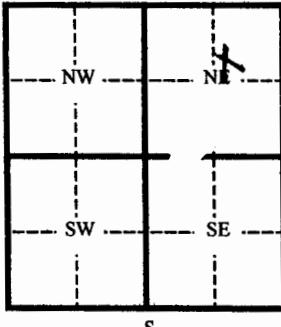


1 LOCATION OF WATER WELL:		Fraction County: Gray SE SW $\frac{1}{4}$ NE $\frac{1}{4}$ NE $\frac{1}{4}$	Section Number 11	Township Number 26	Range Number 28
---------------------------	--	---	----------------------	-----------------------	--------------------

Distance and direction from nearest town or city street address of well if located within city?

2 WATER WELL OWNER: Grasser Oil		Board of Agriculture, Division of Water Resources		
RR#, St. Address, Box #		Application Number:		
City, State, ZIP Code : Cimmaron, Ks 67835				

3 MARK WELL'S LOCATON WITH AN "X" IN SECTION BOX:		4 DEPTH OF WELL 70 ft.	
		WELL'S STATIC WATER LEVEL ft.	
WELL WAS USED AS:			
1 Domestic 5 Public Water Supply 2 Irrigation 6 Oil Field Water Supply 3 Feedlot 7 Lawn and Garden (domestic) 4 Industrial 8 Air Conditioning			
9 Dewatering 10 Monitoring Well 11 Injection Well 12 Other			
Was a chemical/bacteriological sample submitted to Department? Yes _____ No _____			
If yes, mo/day/yr sample was submitted			
Water Well Disinfected: Yes _____ No _____			

5 TYPE OF BLANK CASING USED:					
1 Steel	3 RMP (SR)	5 Wrought	7 Fiberglass	9 Other (specify below)	
<input checked="" type="checkbox"/> 2 PVC	4 ABC	6 Asbestos-Cement	8 Concrete Tile		
Blank casing diameter 2 in.		Was casing pulled? Yes _____ No _____		If yes, how much _____	
Casing height above or below land surface -36 in.					

6 GROUT PLUG MATERIAL: 1 Neat cement 2 Cement grout 3 Bentonite 4 Other					
Grout Plug Intervals From ft. to ft. From ft. to ft. From ft. to ft.					

What is the nearest source of possible contamination:

1 Septic tank	6 Seepage pit	11 Fuel storage	16 Other (specify below)
2 Sewer lines	7 Pit privy	12 Fertilizer storage	
3 Watertight sewer lines	8 Sewage lagoon	13 Insecticide storage	
4 Lateral lines	9 Feedyard	14 Abandoned water well	
5 Cess Pool	10 Livestock pens	15 Oil well/ Gas well	

Direction from well? _____			How many feet? _____
----------------------------	--	--	----------------------

FROM	TO	CODE	PLUGGING MATERIALS
70	3		Benonite
3	.5		topsoil
.5	0		CEMENT
			Drilled out 3 ft casing

7 CONTRACTOR'S OR LANDOWNER'S CERTIFICATION: This water well was plugged under my jurisdiction and was completed on (mo/day/yr) 4-14-05			and this record is true to the best of my knowledge and belief. Kansas
Water Well Contractor's License No. 554			This Water Well Record was completed on (mo/day/yr)
by (signature) 5-13-05 under the business name of Woofter Pump & Well Inc.			<i>Jay C. Woofter</i>

INSTRUCTIONS: Please fill in blanks and circle the correct answers. Send three copies to Kansas Department of Health and Environment, Bureau of Water, 1000 S W Jackson St., Ste. 420, Topeka, Kansas 66620-0001. Telephone: 785-296-3565. Send one to Water Well Owner and retain one for your records.