

1 LOCATION OF WATER WELL:		Fraction	Section Number	Township Number	Range Number
County: Gray	NW	NW $\frac{1}{4}$ SE $\frac{1}{4}$ NE $\frac{1}{4}$	11	26	28

Distance and direction from nearest town or city street address of well if located within city?

2 WATER WELL OWNER: **Grasser Oil**

RR#, St. Address, Box #

City, State, ZIP Code : **Cimmaron, Ks 67835**


Board of Agriculture, Division of Water Resources
Application Number:

3 MARK WELL'S LOCATON WITH AN "X" IN SECTION BOX:

4

DEPTH OF WELL **65** ft.

WELL'S STATIC WATER LEVEL ft.

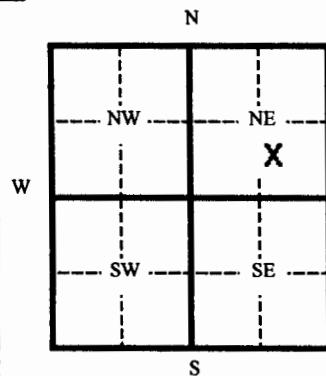

WELL WAS USED AS:

1 Domestic	5 Public Water Supply
2 Irrigation	6 Oil Field Water Supply
3 Feedlot	7 Lawn and Garden (domestic)
4 Industrial	8 Air Conditioning

9 Dewatering
10 Monitoring Well
11 Injection Well
12 Other

Was a chemical/bacteriological sample submitted to Department?

Yes No

If yes, mo/day/yr sample was submitted

Water Well Disinfected: Yes No

5 TYPE OF BLANK CASING USED:

1 Steel	3 RMP (SR)	5 Wrought	7 Fiberglass	9 Other (specify below)
<input checked="" type="checkbox"/> 2 PVC	4 ABC	6 Asbestos-Cement	8 Concrete Tile	

Blank casing diameter **5** in. Was casing pulled? Yes No If yes, how much

Casing height above or below land surface **-36** in.

6 GROUT PLUG MATERIAL: 1 Neat cement 2 Cement grout 3 Bentonite 4 Other

Grout Plug Intervals From ft. to ft. From ft. to ft. From ft. to ft.

What is the nearest source of possible contamination:

1 Septic tank	6 Seepage pit	11 Fuel storage	16 Other (specify below)
2 Sewer lines	7 Pit privy	12 Fertilizer storage	
3 Watertight sewer lines	8 Sewage lagoon	13 Insecticide storage	
4 Lateral lines	9 Feedyard	14 Abandoned water well	
5 Cess Pool	10 Livestock pens	15 Oil well/ Gas well	

Direction from well?

How many feet?

FROM	TO	CODE	PLUGGING MATERIALS
65	3		Benonite
3	0		topsoil
			Removed pad & 8 ft casing

7 CONTRACTOR'S OR LANDOWNER'S CERTIFICATION: This water well was plugged under my jurisdiction and was completed on (mo/day/yr) **4-14-05** and this record is true to the best of my knowledge and belief. Kansas

Water Well Contractor's License No. **554** This Water Well Record was completed on (mo/day/yr)

5-13-05 under the business name of

Woofter Pump & Well Inc.

by (signature) 

INSTRUCTIONS: Please fill in blanks and circle the correct answers. Send three copies to Kansas Department of Health and Environment, Bureau of Water, 1000 S W Jackson St., Ste. 420, Topeka, Kansas 66628-0001. Telephone: 785-296-3565. Send one to Water Well Owner and retain one for your records.