

WATER WELL PLUGGING RECORD

Form WWC-5P

KSA 82a-1212

ID No. OB-1

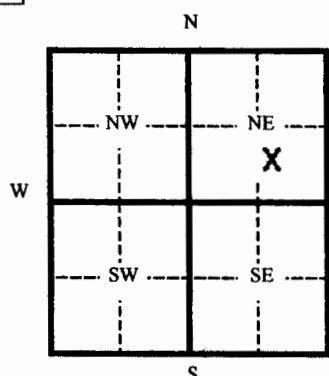
1 LOCATION OF WATER WELL:	Fraction County: Gray NW NW 1/4 SE 1/4 NE 1/4	Section Number 11	Township Number 26	Range Number 28
---------------------------	--	----------------------	-----------------------	--------------------

Distance and direction from nearest town or city street address of well if located within city?

2 WATER WELL OWNER: Grasser Oil

RR#, St. Address, Box #

City, State, ZIP Code : Cimmaron, Ks 67835

Board of Agriculture, Division of Water Resources
Application Number:3 MARK WELL'S LOCATON WITH AN
"X" IN SECTION BOX:

4 DEPTH OF WELL 48 ft.

WELL'S STATIC WATER LEVEL ft.

WELL WAS USED AS:

- | | |
|--------------|------------------------------|
| 1 Domestic | 5 Public Water Supply |
| 2 Irrigation | 6 Oil Field Water Supply |
| 3 Feedlot | 7 Lawn and Garden (domestic) |
| 4 Industrial | 8 Air Conditioning |

- | |
|--------------------|
| 9 Dewatering |
| 10 Monitoring Well |
| 11 Injection Well |
| 12 Other |

Was a chemical/bacteriological sample submitted to Department?

Yes No

If yes, mo/day/yr sample was submitted

Water Well Disinfected: Yes No

5 TYPE OF BLANK CASING USED:

- | | |
|---------|------------|
| 1 Steel | 3 RMP (SR) |
| 2 PVC | 4 ABC |

- | | |
|-------------------|-----------------|
| 5 Wrought | 7 Fiberglass |
| 6 Asbestos-Cement | 8 Concrete Tile |

9 Other (specify below)

Blank casing diameter 2 in.

Was casing pulled? Yes No

If yes, how much

Casing height above or below land surface -36 in.

6 GROUT PLUG MATERIAL: 1 Neat cement 2 Cement grout 3 Bentonite 4 Other

Grout Plug Intervals From ft. to ft. From ft. to ft. From ft. to ft.

What is the nearest source of possible contamination:

- | | | | |
|--------------------------|-------------------|-------------------------|--------------------------|
| 1 Septic tank | 6 Seepage pit | 11 Fuel storage | 16 Other (specify below) |
| 2 Sewer lines | 7 Pit privy | 12 Fertilizer storage | |
| 3 Watertight sewer lines | 8 Sewage lagoon | 13 Insecticide storage | |
| 4 Lateral lines | 9 Feedyard | 14 Abandoned water well | |
| 5 Cess Pool | 10 Livestock pens | 15 Oil well/ Gas well | |

Direction from well?

How many feet?

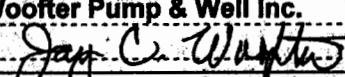
FROM	TO	CODE	PLUGGING MATERIALS
48	3		Benonite
3	0		topsoil
Pulled 20 ft screen & 28 ft casing			

7 CONTRACTOR'S OR LANDOWNER'S CERTIFICATION: This water well was plugged under my jurisdiction and was completed on (mo/day/yr) 4-14-05 and this record is true to the best of my knowledge and belief. Kansas

Water Well Contractor's License No. 554 This Water Well Record was completed on (mo/day/yr)

5-13-05 under the business name of

Woofter Pump & Well Inc.

by (signature) 

INSTRUCTIONS: Please fill in blanks and circle the correct answer. Send three copies to Kansas Department of Health and Environment, Bureau of Water, 1000 S W Jackson St., Ste. 420, Topeka, Kansas 66620-0001. Telephone: 785-296-3565. Send one to Water Well Owner and retain one for your records.