


402 W Ave A

Attn: Jake Osborne

Application Number:

AN "X" IN SECTION BOX:

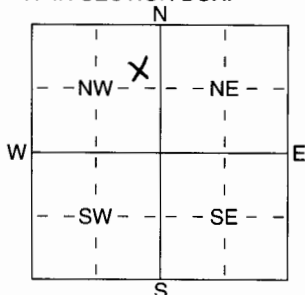

mitted

Water Well Disinfected? Yes No

From	ft.	to	ft.	From	ft.	to	ft.
From	ft	to	ft	From	ft	to	ft

How many feet?

FROM		TO		LITHOLOGIC LOG	FROM	TO	PLUGGING INTERVALS
0	0.5			Concrete			
0.5	8			Clay, moist			
8	23			Silty clay, dry			
23	34			Clay, moist			
34	35			Sandy clay, moist, very fine to fine grained			
35	60			Gravelly sand, fine to gravel, dry			
							MW11

under the business name of Canaan Court Plaza Tea by (signature) [Signature]