

1 LOCATION OF WATER WELL:	Fraction	Section Number	Township Number	Range Number
County: <u>Gray</u>	<u>SE</u> $\frac{1}{4}$ <u>NE</u> $\frac{1}{4}$ <u>NW</u> $\frac{1}{4}$	<u>11</u>	<u>T 26 S</u>	<u>R 28 E/W</u>

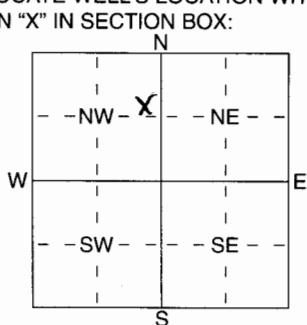
Distance and direction from nearest town or city street address of well if located within city?

402 W Ave A2 WATER WELL OWNER: Jake Osborn & Service, Inc.RR#, St. Address, Box # : Attn: Jake OsbornCity, State, ZIP Code : P.O. Box 492
Cimarron, KS 67835

Board of Agriculture, Division of Water Resources

Application Number:

3 LOCATE WELL'S LOCATION WITH AN "X" IN SECTION BOX:

4 DEPTH OF COMPLETED WELL 60 ft. ELEVATION:Depth(s) Groundwater Encountered 1 15 ft. 2 _____ ft. 3 _____ ft.

WELL'S STATIC WATER LEVEL _____ ft. below land surface measured on mo/day/yr _____

Pump test data: Well water was _____ ft. after _____ hours pumping _____ gpm

Est. Yield _____ gpm: Well water was _____ ft. after _____ hours pumping _____ gpm

WELL WATER TO BE USED AS: 5 Public water supply 8 Air conditioning 11 Injection well

1 Domestic 3 Feedlot 6 Oil field water supply 9 Dewatering 12 Other (Specify below)

2 Irrigation 4 Industrial 7 Domestic (lawn & garden) 10 Monitoring wellWas a chemical/bacteriological sample submitted to Department? Yes _____ No X; If yes, mo/day/yr sample was submitted
Water Well Disinfected? Yes _____ No X

5 TYPE OF BLANK CASING USED:

1 Steel 3 RMP (SR) 5 Wrought iron 8 Concrete tile CASING JOINTS: Glued _____ Clamped _____

2 PVC 4 ABS 6 Asbestos-Cement 9 Other (specify below) Welded _____7 Fiberglass _____ Threaded XBlank casing diameter 2 in. to 60 ft. Dia _____ in. to _____ ft. Dia _____ in. to _____ ft.Casing height above land surface 3 in. weight 0.8 lbs./ft. Wall thickness or gauge No. Sch 40 PVC

TYPE OF SCREEN OR PERFORATION MATERIAL:

1 Steel 3 Stainless Steel 5 Fiberglass 8 RMP (SR) 10 Asbestos-Cement

2 Brass 4 Galvanized Steel 6 Concrete tile 9 ABS 11 Other (Specify) _____

12 None used (open hole)

SCREEN OR PERFORATION OPENINGS ARE:

1 Continuous slot 4 Mill slot 5 Gauzed wrapped 8 Saw cut 11 None (open hole)

2 Louvered shutter 4 Key punched 6 Wire wrapped 9 Drilled holes

7 Torch cut 10 Other (specify) _____ ft.

SCREEN-PERFORATED INTERVALS: From 30 ft. to 60 ft. From _____ ft. to _____ ft.GRAVEL PACK INTERVALS: From 28 ft. to 60 ft. From _____ ft. to _____ ft.

From _____ ft. to _____ ft. From _____ ft. to _____ ft.

6 GROUT MATERIAL: 1 Neat cement 2 Cement grout 3 Bentonite 4 Other _____Grout Intervals: From 1 ft. to 28 ft. From _____ ft. to _____ ft. From _____ ft. to _____ ft.

What is the nearest source of possible contamination:

1 Septic tank 4 Lateral lines 7 Pit privy 10 Livestock pens 14 Abandoned water well

2 Sewer lines 5 Cess pool 8 Sewage lagoon 11 Fuel storage 15 Oil well/Gas well

3 Watertight sewer lines 6 Seepage pit 9 Feedyard 12 Fertilizer storage 16 Other (specify below)

Direction from well? _____ How many feet? _____

FROM TO LITHOLOGIC LOG FROM TO PLUGGING INTERVALS

0 0.5 Concrete

0.5 1.3 Clay, some silt, moist

1.3 1.5 Sandy clay, moist

1.5 3.6 Clay, moist

3.6 60 Gravelly sand, fine to gravel, dry

MW 12

7 CONTRACTOR'S OR LANDOWNER'S CERTIFICATION: This water well was (1) constructed, (2) reconstructed, or (3) plugged under my jurisdiction and was

completed on (mo/day/year) 3/24/95 and this record is true to the best of my knowledge and belief. KansasWater Well Contractor's Licence No 349 This Water Well Record was completed on (mo/day/yr) 5/19/05under the business name of Coranco Great Plains, Inc. by (signature) [Signature]