

1 LOCATION OF WATER WELL:	Fraction	Section Number	Township Number	Range Number
County: Gray	NW ¼ SE ¼ NE ¼	11	26S	28W

Distance and direction from nearest town or city street address of well if located within city?

2 WATER WELL OWNER: **Grasser Oil**RR#, St. Address, Box # **210 East Ave. A**

Board of Agriculture, Division of Water Resources

City, State, ZIP Code : **Cimarron, KS 67835**

Application Number:

3 MARK WELL'S LOCATION WITH AN "X" IN SECTION BOX:

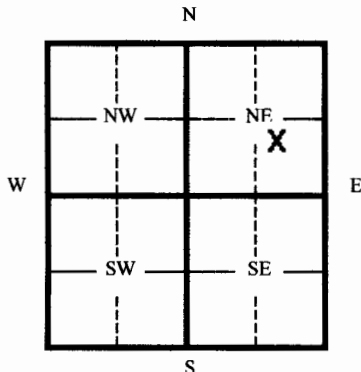
4 DEPTH OF WELL **42.6** ft.WELL'S STATIC WATER LEVEL **dry** ft.

WELL WAS USED AS:

- | | | |
|--------------|------------------------------|--|
| 1 Domestic | 5 Public Water Supply | 9 Dewatering |
| 2 Irrigation | 6 Oil Field Water Supply | 10 Monitoring Well |
| 3 Feedlot | 7 Lawn and Garden (domestic) | <input checked="" type="radio"/> 11 Injection Well |
| 4 Industrial | 8 Air Conditioning | 12 Other |

Was a chemical/bacteriological sample submitted to Department? Yes No ☒

If yes, mo/day/yr sample was submitted

Water Well Disinfected: Yes No ☒

5 TYPE OF BLANK CASING USED:

- | | | | | |
|--|------------|-------------------|-----------------|-------------------------|
| 1 Steel | 3 RMP (SR) | 5 Wrought | 7 Fiberglass | 9 Other (specify below) |
| <input checked="" type="radio"/> 2 PVC | 4 ABC | 6 Asbestos-Cement | 8 Concrete Tile | |
- Blank casing diameter **2** in. Was casing pulled? Yes No ☒ If yes, how much **Overdrilled 5 feet**
- Casing height above or below land surface **0** in.

6 GROUT PLUG MATERIAL: 1 Neat cement 2 Cement grout ☒ 3 Bentonite 4 OtherGrout Plug Intervals From **3** ft. to **42.6** ft. From ft. to ft. From ft. to ft.

What is the nearest source of possible contamination:

- | | | | |
|--------------------------|-------------------|-------------------------|-------------------------------------|
| 1 Septic tank | 6 Seepage pit | 11 Fuel storage | 16 Other (specify below) |
| 2 Sewer lines | 7 Pit privy | 12 Fertilizer storage | Previously Contaminated Site |
| 3 Watertight sewer lines | 8 Sewage lagoon | 13 Insecticide storage | |
| 4 Lateral lines | 9 Feedyard | 14 Abandoned water well | |
| 5 Cess Pool | 10 Livestock pens | 15 Oil well/ Gas well | |

Direction from well?

How many feet?

FROM	TO	CODE	PLUGGING MATERIALS
0	3		Concrete
3	42.6		Bentonite

7 CONTRACTOR'S OR LANDOWNER'S CERTIFICATION: This water well was plugged under my jurisdiction and was completed on (mo/day/yr) **2-21-06** and this record is true to the best of my knowledge and belief. Kansas Water Well Contractor's License No. **554** This Water Well Record was completed on (mo/day/yr) **3-27-06** under the business name of **Woofert Pump & Well, Inc.**

by (signature) *[Signature]*

INSTRUCTIONS: Please fill in blanks and circle the correct answers. Send three copies to Kansas Department of Health and Environment, Bureau of Water, 1000 S W Jackson St., Ste. 420, Topeka, Kansas 66620-0001. Telephone: 785-296-3565. Send one to Water Well Owner and retain one for your records.