


1 LOCATION OF WATER WELL:	Fraction NW 1/4 SE 1/4 NE 1/4	Section Number 11	Township Number 26S	Range Number 28W
---------------------------	---	-----------------------------	-------------------------------	----------------------------

Distance and direction from nearest town or city street address of well if located within city?

2 WATER WELL OWNER:	Grasser Oil	Board of Agriculture, Division of Water Resources
RR#, St. Address, Box #	210 East Ave. A	Application Number:

City, State, ZIP Code : **Cimarron, KS 67835**

3 MARK WELL'S LOCATON WITH AN "X" IN SECTION BOX:	N	4 DEPTH OF WELL 47.95 ft.
		WELL'S STATIC WATER LEVEL 45.3 ft.
		WELL WAS USED AS:
		1 Domestic 5 Public Water Supply 9 Dewatering 2 Irrigation 6 Oil Field Water Supply 10 Monitoring Well 3 Feedlot 7 Lawn and Garden (domestic) 11 Injection Well 4 Industrial 8 Air Conditioning 12 Other
		Was a chemical/bacteriological sample submitted to Department? Yes <input type="checkbox"/> No <input checked="" type="checkbox"/> If yes, mo/day/yr sample was submitted _____
		Water Well Disinfected: Yes <input type="checkbox"/> No <input checked="" type="checkbox"/>

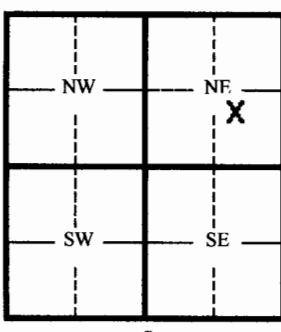

5 TYPE OF BLANK CASING USED:	1 Steel	3 RMP (SR)	5 Wrought	7 Fiberglass	9 Other (specify below)
	<input checked="" type="radio"/> PVC	4 ABC	6 Asbestos-Cement	8 Concrete Tile	
Blank casing diameter	2	in.	Was casing pulled?	Yes <input type="checkbox"/> No <input checked="" type="checkbox"/>	If yes, how much Overdrilled 3 feet
Casing height above or below land surface	0	in.			

6 GROUT PLUG MATERIAL:	1 Neat cement	2 Cement grout	3 Bentonite	4 Other
Grout Plug Intervals	From 3 ft. to 47.95 ft.	From _____ ft. to _____ ft.	From _____ ft. to _____ ft.	From _____ ft. to _____ ft.

What is the nearest source of possible contamination:

1 Septic tank	6 Seepage pit	11 Fuel storage	16 Other (specify below)
2 Sewer lines	7 Pit privy	12 Fertilizer storage	Previously Contaminated Site
3 Watertight sewer lines	8 Sewage lagoon	13 Insecticide storage	
4 Lateral lines	9 Feedyard	14 Abandoned water well	
5 Cess Pool	10 Livestock pens	15 Oil well/ Gas well	

Direction from well? _____ How many feet? _____

FROM	TO	CODE	PLUGGING MATERIALS
0	3		Concrete
3	47.95		Bentonite

7	CONTRACTOR'S OR LANDOWNER'S CERTIFICATION: This water well was plugged under my jurisdiction and was completed on (mo/day/yr) 2-22-06 and this record is true to the best of my knowledge and belief. Kansas Water Well Contractor's License No. 554 This Water Well Record was completed on (mo/day/yr) 3-27-06 under the business name of Woofer Pump & Well, Inc. by (signature) <i>Grayle Woofer</i>
---	--

INSTRUCTIONS: Please fill in blanks and circle the correct answers. Send three copies to Kansas Department of Health and Environment, Bureau of Water, 1000 S W Jackson St., Ste. 420, Topeka, Kansas 66620-0001. Telephone: 785-296-3565. Send one to Water Well Owner and retain one for your records.