

## WATER WELL PLUGGING RECORD

## Form WWC-5P

## KSA 82a-1212

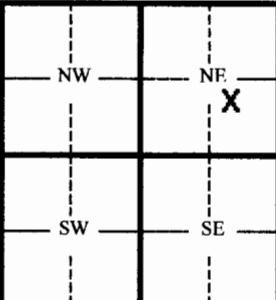
ID No. **MW-3**

1 LOCATION OF WATER WELL:	Fraction	Section Number	Township Number	Range Number
County: <b>Gray</b>	<b>NW 1/4</b>	<b>SE 1/4</b>	<b>NE 1/4</b>	<b>11</b>

Distance and direction from nearest town or city street address of well if located within city?

2 WATER WELL OWNER:	<b>Grasser Oil</b>	Board of Agriculture, Division of Water Resources
RR#, St. Address, Box #	<b>210 East Ave. A</b>	Application Number:

City, State, ZIP Code : **Cimarron, KS 67835**

3 MARK WELL'S LOCATON WITH AN "X" IN SECTION BOX:	4 DEPTH OF WELL	47.3	ft.
	WELL'S STATIC WATER LEVEL	<b>dry</b>	ft.
WELL WAS USED AS:			
1 Domestic      5 Public Water Supply      9 Dewatering 2 Irrigation      6 Oil Field Water Supply      10 Monitoring Well 3 Feedlot      7 Lawn and Garden (domestic)      11 Injection Well 4 Industrial      8 Air Conditioning      12 Other			
Was a chemical/bacteriological sample submitted to Department? Yes <input type="checkbox"/> No <b>X</b>			
If yes, mo/day/yr sample was submitted			
Water Well Disinfected: Yes <input type="checkbox"/> No <b>X</b>			

5 TYPE OF BLANK CASING USED:	1 Steel	3 RMP (SR)	5 Wrought	7 Fiberglass	9 Other (specify below)
	<b>2 PVC</b>	4 ABC	6 Asbestos-Cement	8 Concrete Tile	
Blank casing diameter	<b>2</b>	in.	Was casing pulled? Yes <input type="checkbox"/> No <b>X</b>	If yes, how much	<b>Overdrilled 3 feet</b>

Casing height above or below land surface **0** in.

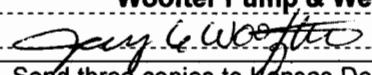
6 GROUT PLUG MATERIAL:	1 Neat cement	2 Cement grout	3 Bentonite	4 Other
Grout Plug Intervals	From <b>3</b> ft. to <b>47.3</b> ft.	From	ft. to	ft. From ft. to ft.

What is the nearest source of possible contamination:

1 Septic tank	6 Seepage pit	11 Fuel storage	16 Other (specify below)
2 Sewer lines	7 Pit privy	12 Fertilizer storage	<b>Previously Contaminated Site</b>
3 Watertight sewer lines	8 Sewage lagoon	13 Insecticide storage	
4 Lateral lines	9 Feedyard	14 Abandoned water well	
5 Cess Pool	10 Livestock pens	15 Oil well/ Gas well	

Direction from well? How many feet?

FROM	TO	CODE	PLUGGING MATERIALS
<b>0</b>	<b>1</b>		<b>Asphalt</b>
<b>1</b>	<b>47.3</b>		<b>Bentonite</b>

7 CONTRACTOR'S OR LANDOWNER'S CERTIFICATION:	This water well was plugged under my jurisdiction and was completed on (mo/day/yr) <b>2-22-06</b> and this record is true to the best of my knowledge and belief. Kansas		
Water Well Contractor's License No. <b>554</b>	<b>3-27-06</b>	under the business name of	This Water Well Record was completed on (mo/day/yr) <b>Woofter Pump &amp; Well, Inc.</b>
by (signature) 			

INSTRUCTIONS: Please fill in blanks and circle the correct answers. Send three copies to Kansas Department of Health and Environment, Bureau of Water, 1000 S W Jackson St., Ste. 420, Topeka, Kansas 66620-0001. Telephone: 785-296-3565. Send one to Water Well Owner and retain one for your records.