


1 LOCATION OF WATER WELL:	Fraction NW 1/4 SE 1/4 NE 1/4	Section Number 11	Township Number 26S	Range Number 28W
---------------------------	---	-----------------------------	-------------------------------	----------------------------

Distance and direction from nearest town or city street address of well if located within city?

2 WATER WELL OWNER:	Grasser Oil	Board of Agriculture, Division of Water Resources
RR#, St. Address, Box #	210 East Ave. A	Application Number:

City, State, ZIP Code : **Cimarron, KS 67835**

3 MARK WELL'S LOCATON WITH AN "X" IN SECTION BOX:

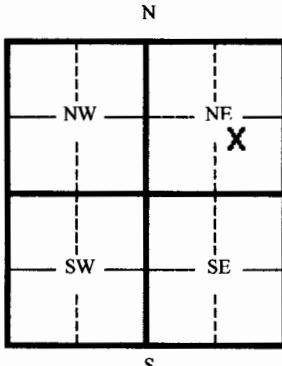

4 DEPTH OF WELL **47.8** ft.

WELL'S STATIC WATER LEVEL **44.9** ft.

WELL WAS USED AS:

1 Domestic	5 Public Water Supply	9 Dewatering
2 Irrigation	6 Oil Field Water Supply	10 Monitoring Well
3 Feedlot	7 Lawn and Garden (domestic)	11 Injection Well
4 Industrial	8 Air Conditioning	12 Other

Was a chemical/bacteriological sample submitted to Department?

Yes No

If yes, mo/day/yr sample was submitted

Water Well Disinfected: Yes No

5 TYPE OF BLANK CASING USED:

1 Steel 3 RMP (SR) 5 Wrought 7 Fiberglass 9 Other (specify below)

2 PVC 4 ABC 6 Asbestos-Cement 8 Concrete Tile

Blank casing diameter **2** in. Was casing pulled? Yes No If yes, how much **Overdrilled 3 feet**

Casing height above or below land surface **0** in.

6 GROUT PLUG MATERIAL: 1 Neat cement 2 Cement grout 3 Bentonite 4 Other

Grout Plug Intervals From **3** ft. to **47.8** ft. From _____ ft. to _____ ft. From _____ ft. to _____ ft.

What is the nearest source of possible contamination:

1 Septic tank	6 Seepage pit	11 Fuel storage	16 Other (specify below)
2 Sewer lines	7 Pit privy	12 Fertilizer storage	Previously Contaminated Site
3 Watertight sewer lines	8 Sewage lagoon	13 Insecticide storage	
4 Lateral lines	9 Feedyard	14 Abandoned water well	
5 Cess Pool	10 Livestock pens	15 Oil well/ Gas well	

Direction from well? _____ How many feet? _____


FROM	TO	CODE	PLUGGING MATERIALS
0	3		Gravel
3	47.8		Bentonite

7 CONTRACTOR'S OR LANDOWNER'S CERTIFICATION: This water well was plugged under my jurisdiction and was completed on (mo/day/yr) **2-22-06** and this record is true to the best of my knowledge and belief. Kansas

Water Well Contractor's License No. **554** This Water Well Record was completed on (mo/day/yr)

3-27-06 under the business name of

Woofter Pump & Well, Inc.

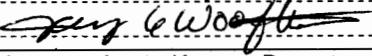by (signature) 

INSTRUCTIONS: Please fill in blanks and circle the correct answers. Send three copies to Kansas Department of Health and Environment, Bureau of Water, 1000 S W Jackson St., Ste. 420, Topeka, Kansas 66620-0001. Telephone: 785-296-3565. Send one to Water Well Owner and retain one for your records.