

WATER WELL PLUGGING RECORD

Form WWC-5P

KSA 82a-1212

ID No. **MW-17**


1 LOCATION OF WATER WELL:	Fraction	Section Number	Township Number	Range Number
County: Gray	NW 1/4 SE 1/4 NE 1/4	11	26S	28W

Distance and direction from nearest town or city street address of well if located within city?

2 WATER WELL OWNER:	Grasser Oil	Board of Agriculture, Division of Water Resources
RR#, St. Address, Box #	210 East Ave. A	Application Number:

City, State, ZIP Code : **Cimarron, KS 67835**

3 MARK WELL'S LOCATON WITH AN "X" IN SECTION BOX:	N	4 DEPTH OF WELL	52 ft.
		WELL'S STATIC WATER LEVEL	43.55 ft.
		WELL WAS USED AS:	
		1 Domestic	5 Public Water Supply
		2 Irrigation	6 Oil Field Water Supply
		3 Feedlot	7 Lawn and Garden (domestic)
		4 Industrial	8 Air Conditioning
		9 Dewatering	
		10 Monitoring Well	
		11 Injection Well	
		12 Other	
		Was a chemical/bacteriological sample submitted to Department?	Yes <input type="checkbox"/> No X
		If yes, mo/day/yr sample was submitted	
		Water Well Disinfected:	Yes <input type="checkbox"/> No X

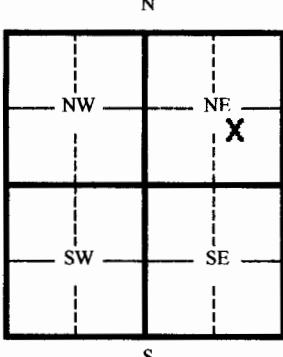

5 TYPE OF BLANK CASING USED:	1 Steel	3 RMP (SR)	5 Wrought	7 Fiberglass	9 Other (specify below)
	2 PVC	4 ABC	6 Asbestos-Cement	8 Concrete Tile	
Blank casing diameter	2 in.	Was casing pulled?	Yes <input type="checkbox"/> No X	If yes, how much	Overdrilled 3 feet
Casing height above or below land surface	0 in.				

6 GROUT PLUG MATERIAL:	1 Neat cement	2 Cement grout	3 Bentonite	4 Other
Grout Plug Intervals	From 3 ft. to 52 ft.	From	ft. to	ft. From

What is the nearest source of possible contamination:

1 Septic tank	6 Seepage pit	11 Fuel storage	16 Other (specify below)
2 Sewer lines	7 Pit privy	12 Fertilizer storage	Previously Contaminated Site
3 Watertight sewer lines	8 Sewage lagoon	13 Insecticide storage	
4 Lateral lines	9 Feedyard	14 Abandoned water well	
5 Cess Pool	10 Livestock pens	15 Oil well/ Gas well	

Direction from well? _____ How many feet? _____

FROM	TO	CODE	PLUGGING MATERIALS
0	3		Gravel
3	52		Bentonite

7 CONTRACTOR'S OR LANDOWNER'S CERTIFICATION:	This water well was plugged under my jurisdiction and was completed on (mo/day/yr) 2-22-06 and this record is true to the best of my knowledge and belief. Kansas Water Well Contractor's License No. 554 This Water Well Record was completed on (mo/day/yr) 3-27-06 under the business name of Woofter Pump & Well, Inc.		
by (signature)	<i>George L. Woofter</i>		

INSTRUCTIONS: Please fill in blanks and circle the correct answers. Send three copies to Kansas Department of Health and Environment, Bureau of Water, 1000 S W Jackson St., Ste. 420, Topeka, Kansas 66620-0001. Telephone: 785-296-3565. Send one to Water Well Owner and retain one for your records.