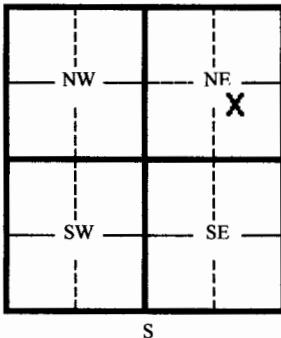


1 LOCATION OF WATER WELL:	Fraction County: Gray NW $\frac{1}{4}$ SE $\frac{1}{4}$ NE $\frac{1}{4}$	Section Number 11	Township Number 26S	Range Number 28W
---------------------------	--	----------------------	------------------------	---------------------

Distance and direction from nearest town or city street address of well if located within city?

2 WATER WELL OWNER:	Grasser Oil RR#, St. Address, Box # 210 East Ave. A	Board of Agriculture, Division of Water Resources Application Number:
City, State, ZIP Code	Cimarron, KS 67835	

3 MARK WELL'S LOCATON WITH AN "X" IN SECTION BOX:	N  E W S	4 DEPTH OF WELL 38 ft. WELL'S STATIC WATER LEVEL dry ft. WELL WAS USED AS: 1 Domestic 5 Public Water Supply 9 Dewatering 2 Irrigation 6 Oil Field Water Supply 10 Monitoring Well 3 Feedlot 7 Lawn and Garden (domestic) 11 Injection Well 4 Industrial 8 Air Conditioning 12 Other Extraction Well
---	--	--

Was a chemical/bacteriological sample submitted to Department? Yes _____ No X

If yes, mo/day/yr sample was submitted _____

Water Well Disinfected: Yes _____ No X

5 TYPE OF BLANK CASING USED:	1 Steel 3 RMP (SR)	5 Wrought 7 Fiberglass	9 Other (specify below)
<input checked="" type="radio"/> PVC	4 ABC	6 Asbestos-Cement 8 Concrete Tile	
Blank casing diameter	4 in.	Was casing pulled? Yes _____ No <input checked="" type="checkbox"/> X	If yes, how much Overdrilled 20 feet

Casing height above or below land surface 0 in.


6 GROUT PLUG MATERIAL:	1 Neat cement	2 Cement grout	<input checked="" type="radio"/> 3 Bentonite	4 Other _____
Grout Plug Intervals	From 3 ft. to 38 ft.	From _____ ft. to _____ ft.	From _____ ft. to _____ ft.	From _____ ft. to _____ ft.

What is the nearest source of possible contamination:

1 Septic tank	6 Seepage pit	11 Fuel storage	16 Other (specify below)
2 Sewer lines	7 Pit privy	12 Fertilizer storage	<input checked="" type="checkbox"/> Previously Contaminated Site
3 Watertight sewer lines	8 Sewage lagoon	13 Insecticide storage	
4 Lateral lines	9 Feedyard	14 Abandoned water well	
5 Cess Pool	10 Livestock pens	15 Oil well/ Gas well	

Direction from well? _____ How many feet? _____

FROM	TO	CODE	PLUGGING MATERIALS
0	3		Concrete
3	38		Bentonite

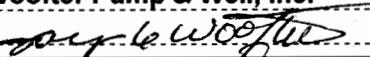7 CONTRACTOR'S OR LANDOWNER'S CERTIFICATION:	This water well was plugged under my jurisdiction and was completed on (mo/day/yr) 2-22-06 and this record is true to the best of my knowledge and belief. Kansas Water Well Contractor's License No. 554 This Water Well Record was completed on (mo/day/yr) 3-27-06 under the business name of Woofter Pump & Well, Inc. by (signature) 
--	--

INSTRUCTIONS: Please fill in blanks and circle the correct answers. Send three copies to Kansas Department of Health and Environment, Bureau of Water, 1000 S W Jackson St., Ste. 420, Topeka, Kansas 66620-0001. Telephone: 785-296-3565. Send one to Water Well Owner and retain one for your records.