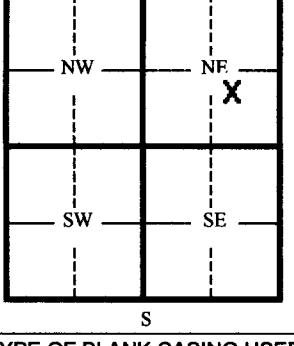


WATER WELL PLUGGING RECORD

Form WWC-5P

KSA 82a-1212

ID No. **SVE-6**

| 1 LOCATION OF WATER WELL: | | Fraction NW 1/4 SE 1/4 NE 1/4 | | | Section Number 11 | Township Number 26S | Range Number 28W | | | | | | | | | | | | | | | | | | | | | | | | | | | | | | | | | | | | |
|---|
| Distance and direction from nearest town or city street address of well if located within city? | |
| 2 WATER WELL OWNER: Grasser Oil RR#, St. Address, Box # 210 East Ave. A City, State, ZIP Code Cimarron, KS 67835 | | | | Board of Agriculture, Division of Water Resources Application Number: | |
| 3 MARK WELL'S LOCATON WITH AN "X" IN SECTION BOX: | | 4 DEPTH OF WELL 36.72 ft. WELL'S STATIC WATER LEVEL dry ft. WELL WAS USED AS: <table> <tr><td>1 Domestic</td><td>5 Public Water Supply</td><td>9 Dewatering</td></tr> <tr><td>2 Irrigation</td><td>6 Oil Field Water Supply</td><td>10 Monitoring Well</td></tr> <tr><td>3 Feedlot</td><td>7 Lawn and Garden (domestic)</td><td>11 Injection Well</td></tr> <tr><td>4 Industrial</td><td>8 Air Conditioning</td><td>(12) Other Extraction Well</td></tr> </table> Was a chemical/bacteriological sample submitted to Department? If yes, mo/day/yr sample was submitted Water Well Disinfected: Yes <input type="checkbox"/> No <input checked="" type="checkbox"/> | | | | | | 1 Domestic | 5 Public Water Supply | 9 Dewatering | 2 Irrigation | 6 Oil Field Water Supply | 10 Monitoring Well | 3 Feedlot | 7 Lawn and Garden (domestic) | 11 Injection Well | 4 Industrial | 8 Air Conditioning | (12) Other Extraction Well | | | | | | | | | | | | | | | | | | | | | | | | |
| 1 Domestic | 5 Public Water Supply | 9 Dewatering | |
| 2 Irrigation | 6 Oil Field Water Supply | 10 Monitoring Well | |
| 3 Feedlot | 7 Lawn and Garden (domestic) | 11 Injection Well | |
| 4 Industrial | 8 Air Conditioning | (12) Other Extraction Well | |
| |
| 5 TYPE OF BLANK CASING USED: 1 Steel 3 RMP (SR) 5 Wrought 7 Fiberglass 9 Other (specify below) (2) PVC 4 ABC 6 Asbestos-Cement 8 Concrete Tile Blank casing diameter 4 in. Was casing pulled? Yes <input type="checkbox"/> No <input checked="" type="checkbox"/> If yes, how much Overdrilled 20 feet Casing height above or below land surface 0 in. | |
| 6 GROUT PLUG MATERIAL: 1 Neat cement 2 Cement grout (3) Bentonite 4 Other Grout Plug Intervals From 3 ft. to 36.72 ft. From _____ ft. to _____ ft. From _____ ft. to _____ ft. What is the nearest source of possible contamination: <table> <tr><td>1 Septic tank</td><td>6 Seepage pit</td><td>11 Fuel storage</td><td>16 Other (specify below)</td></tr> <tr><td>2 Sewer lines</td><td>7 Pit privy</td><td>12 Fertilizer storage</td><td>Previously Contaminated Site</td></tr> <tr><td>3 Watertight sewer lines</td><td>8 Sewage lagoon</td><td>13 Insecticide storage</td><td></td></tr> <tr><td>4 Lateral lines</td><td>9 Feedyard</td><td>14 Abandoned water well</td><td></td></tr> <tr><td>5 Cess Pool</td><td>10 Livestock pens</td><td>15 Oil well/ Gas well</td><td></td></tr> </table> | | | | | | | | 1 Septic tank | 6 Seepage pit | 11 Fuel storage | 16 Other (specify below) | 2 Sewer lines | 7 Pit privy | 12 Fertilizer storage | Previously Contaminated Site | 3 Watertight sewer lines | 8 Sewage lagoon | 13 Insecticide storage | | 4 Lateral lines | 9 Feedyard | 14 Abandoned water well | | 5 Cess Pool | 10 Livestock pens | 15 Oil well/ Gas well | | | | | | | | | | | | | | | | | |
| 1 Septic tank | 6 Seepage pit | 11 Fuel storage | 16 Other (specify below) | |
| 2 Sewer lines | 7 Pit privy | 12 Fertilizer storage | Previously Contaminated Site | |
| 3 Watertight sewer lines | 8 Sewage lagoon | 13 Insecticide storage | |
| 4 Lateral lines | 9 Feedyard | 14 Abandoned water well | |
| 5 Cess Pool | 10 Livestock pens | 15 Oil well/ Gas well | |
| Direction from well? _____ How many feet? _____ | |
| <table border="1"> <thead> <tr> <th>FROM</th> <th>TO</th> <th>CODE</th> <th>PLUGGING MATERIALS</th> </tr> </thead> <tbody> <tr><td>0</td><td>3</td><td></td><td>Concrete</td></tr> <tr><td>3</td><td>36.72</td><td></td><td>Bentonite</td></tr> <tr><td></td><td></td><td></td><td></td></tr> <tr><td></td><td></td><td></td><td></td></tr> <tr><td></td><td></td><td></td><td></td></tr> <tr><td></td><td></td><td></td><td></td></tr> <tr><td></td><td></td><td></td><td></td></tr> <tr><td></td><td></td><td></td><td></td></tr> </tbody> </table> | | | | | | | | FROM | TO | CODE | PLUGGING MATERIALS | 0 | 3 | | Concrete | 3 | 36.72 | | Bentonite | | | | | | | | | | | | | | | | | | | | | | | | |
| FROM | TO | CODE | PLUGGING MATERIALS | |
| 0 | 3 | | Concrete | |
| 3 | 36.72 | | Bentonite | |
| |
| |
| |
| |
| |
| |
| 7 CONTRACTOR'S OR LANDOWNER'S CERTIFICATION: This water well was plugged under my jurisdiction and was completed on (mo/day/yr) 2-22-06 and this record is true to the best of my knowledge and belief. Kansas Water Well Contractor's License No. 554 This Water Well Record was completed on (mo/day/yr) 3-27-06 under the business name of Woofter Pump & Well, Inc. by (signature)  | |