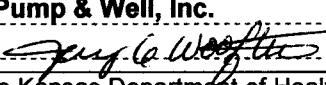


WATER WELL PLUGGING RECORD

Form WWC-5P

KSA 82a-1212

ID No. **SVE-7**

| 1 LOCATION OF WATER WELL: | | Fraction NW 1/4 SE 1/4 NE 1/4 | Section Number 11 | Township Number 26S | Range Number 28W | |
|---|
| Distance and direction from nearest town or city street address of well if located within city? | |
| 2 WATER WELL OWNER: Grasser Oil RR#, St. Address, Box # 210 East Ave. A Board of Agriculture, Division of Water Resources City, State, ZIP Code Cimarron, KS 67835 Application Number: | |
| 3 MARK WELL'S LOCATON WITH AN "X" IN SECTION BOX: | | 4 DEPTH OF WELL 37.82 ft. WELL'S STATIC WATER LEVEL dry ft. WELL WAS USED AS: <table style="margin-left: 100px;"> <tr><td>1 Domestic</td><td>5 Public Water Supply</td><td>9 Dewatering</td></tr> <tr><td>2 Irrigation</td><td>6 Oil Field Water Supply</td><td>10 Monitoring Well</td></tr> <tr><td>3 Feedlot</td><td>7 Lawn and Garden (domestic)</td><td>11 Injection Well</td></tr> <tr><td>4 Industrial</td><td>8 Air Conditioning</td><td>(12) Other Extraction Well</td></tr> </table> Was a chemical/bacteriological sample submitted to Department? Yes <input type="checkbox"/> No <input checked="" type="checkbox"/> If yes, mo/day/yr sample was submitted _____ Water Well Disinfected: Yes <input type="checkbox"/> No <input checked="" type="checkbox"/> | 
| 5 TYPE OF BLANK CASING USED: <table style="margin-left: 100px;"> <tr><td>1 Steel</td><td>3 RMP (SR)</td><td>5 Wrought</td><td>7 Fiberglass</td><td>9 Other (specify below)</td></tr> <tr><td>2 PVC</td><td>4 ABC</td><td>6 Asbestos-Cement</td><td>8 Concrete Tile</td><td></td></tr> </table> Blank casing diameter 4 in. Was casing pulled? Yes <input type="checkbox"/> No <input checked="" type="checkbox"/> If yes, how much Overdrilled 20 feet Casing height above or below land surface 0 in. | | | | | | 1 Steel | 3 RMP (SR) | 5 Wrought | 7 Fiberglass | 9 Other (specify below) | 2 PVC | 4 ABC | 6 Asbestos-Cement | 8 Concrete Tile | |
| 1 Steel | 3 RMP (SR) | 5 Wrought | 7 Fiberglass | 9 Other (specify below) | |
| 2 PVC | 4 ABC | 6 Asbestos-Cement | 8 Concrete Tile | |
| 6 GROUT PLUG MATERIAL: 1 Neat cement 2 Cement grout 3 Bentonite 4 Other Grout Plug Intervals From 3 ft. to 37.82 ft. From _____ ft. to _____ ft. From _____ ft. to _____ ft. | |
| What is the nearest source of possible contamination: <table style="margin-left: 100px;"> <tr><td>1 Septic tank</td><td>6 Seepage pit</td><td>11 Fuel storage</td><td>16 Other (specify below)</td></tr> <tr><td>2 Sewer lines</td><td>7 Pit privy</td><td>12 Fertilizer storage</td><td>Previously Contaminated Site</td></tr> <tr><td>3 Watertight sewer lines</td><td>8 Sewage lagoon</td><td>13 Insecticide storage</td><td></td></tr> <tr><td>4 Lateral lines</td><td>9 Feedyard</td><td>14 Abandoned water well</td><td></td></tr> <tr><td>5 Cess Pool</td><td>10 Livestock pens</td><td>15 Oil well/ Gas well</td><td></td></tr> </table> | | | | | | 1 Septic tank | 6 Seepage pit | 11 Fuel storage | 16 Other (specify below) | 2 Sewer lines | 7 Pit privy | 12 Fertilizer storage | Previously Contaminated Site | 3 Watertight sewer lines | 8 Sewage lagoon | 13 Insecticide storage | | 4 Lateral lines | 9 Feedyard | 14 Abandoned water well | | 5 Cess Pool | 10 Livestock pens | 15 Oil well/ Gas well | | | | | | | | | | | | | | | | | | | | | | | | | | | | | |
| 1 Septic tank | 6 Seepage pit | 11 Fuel storage | 16 Other (specify below) | |
| 2 Sewer lines | 7 Pit privy | 12 Fertilizer storage | Previously Contaminated Site | |
| 3 Watertight sewer lines | 8 Sewage lagoon | 13 Insecticide storage | |
| 4 Lateral lines | 9 Feedyard | 14 Abandoned water well | |
| 5 Cess Pool | 10 Livestock pens | 15 Oil well/ Gas well | |
| Direction from well? _____ How many feet? _____ | |
| <table border="1" style="width: 100%; border-collapse: collapse;"> <thead> <tr> <th>FROM</th> <th>TO</th> <th>CODE</th> <th colspan="3">PLUGGING MATERIALS</th> </tr> </thead> <tbody> <tr> <td>0</td> <td>3</td> <td></td> <td colspan="3">Concrete</td> </tr> <tr> <td>3</td> <td>37.82</td> <td></td> <td colspan="3">Bentonite</td> </tr> <tr><td> </td><td> </td><td> </td><td> </td><td> </td><td> </td></tr> </tbody> </table> | | | | | | FROM | TO | CODE | PLUGGING MATERIALS | | | 0 | 3 | | Concrete | | | 3 | 37.82 | | Bentonite | | | | | | | | | | | | | | | | | | | | | | | | | | | | | | | | |
| FROM | TO | CODE | PLUGGING MATERIALS | |
| 0 | 3 | | Concrete | |
| 3 | 37.82 | | Bentonite | |
| |
| |
| |
| |
| |
| 7 CONTRACTOR'S OR LANDOWNER'S CERTIFICATION: This water well was plugged under my jurisdiction and was completed on (mo/day/yr) 2-22-06 and this record is true to the best of my knowledge and belief. Kansas Water Well Contractor's License No. 554 This Water Well Record was completed on (mo/day/yr) 3-27-06 under the business name of Woofter Pump & Well, Inc. by (signature)  | |
| INSTRUCTIONS: Please fill in blanks and circle the correct answers. Send three copies to Kansas Department of Health and Environment, Bureau of Water, 1000 S W Jackson St., Ste. 420, Topeka, Kansas 66620-0001. Telephone: 785-296-3565. Send one to Water Well Owner and retain one for your records. | |