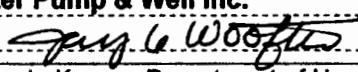


WATER WELL PLUGGING RECORD

Form WWC-5P

KSA 82a-1212

ID No. MW4

1 LOCATION OF WATER WELL:		Fraction SE 1/4 NW 1/4 NE 1/4	Section Number 11	Township Number 26	Range Number 28										
Distance and direction from nearest town or city street address of well if located within city?															
2 WATER WELL OWNER: Grain Growers Coop RR#, St. Address, Box # 202 N Main City, State, ZIP Code Cimarron, KS 67835			Board of Agriculture, Division of Water Resources Application Number:												
3 MARK WELL'S LOCATON WITH AN "X" IN SECTION BOX:		<table border="1" style="margin-left: 100px;"> <tr><td colspan="2">N</td></tr> <tr><td style="text-align: center;">W</td><td style="text-align: center;">X</td></tr> <tr><td colspan="2">E</td></tr> <tr><td colspan="2">SW SE</td></tr> <tr><td colspan="2">S</td></tr> </table>				N		W	X	E		SW SE		S	
N															
W	X														
E															
SW SE															
S															
4 DEPTH OF WELL		59 ft.													
WELL'S STATIC WATER LEVEL		Dry ft.													
WELL WAS USED AS:															
1 Domestic		5 Public Water Supply		9 Dewatering											
2 Irrigation		6 Oil Field Water Supply		10 Monitoring Well											
3 Feedlot		7 Lawn and Garden (domestic)		11 Injection Well											
4 Industrial		8 Air Conditioning		12 Other											
Was a chemical/bacteriological sample submitted to Department? Yes <input type="checkbox"/> No <input checked="" type="checkbox"/>															
If yes, mo/day/yr sample was submitted															
Water Well Disinfected: Yes <input type="checkbox"/> No <input checked="" type="checkbox"/>															
5 TYPE OF BLANK CASING USED:															
1 Steel		3 RMP (SR)		5 Wrought											
<input checked="" type="radio"/> PVC		4 ABC		7 Fiberglass											
Blank casing diameter 2 in.		Was casing pulled? Yes <input checked="" type="checkbox"/> No <input type="checkbox"/>		9 Other (specify below)											
If yes, how much Overdrilled 3 ft.															
Casing height above or below land surface -36 in.															
6 GROUT PLUG MATERIAL: 1 Neat cement 2 Cement grout <input checked="" type="radio"/> 3 Bentonite 4 Other															
Grout Plug Intervals From 0 ft. to 59 ft. From _____ ft. to _____ ft. From _____ ft. to _____ ft.															
What is the nearest source of possible contamination:															
1 Septic tank		6 Seepage pit		11 Fuel storage											
2 Sewer lines		7 Pit privy		12 Fertilizer storage											
3 Watertight sewer lines		8 Sewage lagoon		13 Insecticide storage											
4 Lateral lines		9 Feedyard		14 Abandoned water well											
5 Cess Pool		10 Livestock pens		15 Oil well/ Gas well											
Direction from well?			How many feet?												
FROM	TO	CODE	PLUGGING MATERIALS												
59	3		Bentonite												
3	0		Native Soil												
7	CONTRACTOR'S OR LANDOWNER'S CERTIFICATION: This water well was plugged under my jurisdiction and was completed on (mo/day/yr) 5/16/06 and this record is true to the best of my knowledge and belief. Kansas Water Well Contractor's License No. 554 This Water Well Record was completed on (mo/day/yr) 6/26/06 under the business name of Woofter Pump & Well Inc.														
by (signature) 															
INSTRUCTIONS: Please fill in blanks and circle the correct answers. Send three copies to Kansas Department of Health and Environment, Bureau of Water, 1000 S W Jackson St., Ste. 420, Topeka, Kansas 66620-0001. Telephone: 785-296-3565. Send one to Water Well Owner and retain one for your records.															