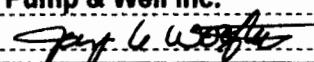


WATER WELL PLUGGING RECORD

Form WWC-5P

KSA 82a-1212

ID No. MW6

1 LOCATION OF WATER WELL:		Fraction SE 1/4 NW 1/4 NE 1/4	Section Number 11	Township Number 26	Range Number 28	
Distance and direction from nearest town or city street address of well if located within city?	
2 WATER WELL OWNER: Grain Growers Coop RR#, St. Address, Box # 202 N Main City, State, ZIP Code Cimarron, KS 67835 Board of Agriculture, Division of Water Resources Application Number:	
3 MARK WELL'S LOCATON WITH AN "X" IN SECTION BOX:		<table border="1" style="float: left; margin-right: 10px;"> <tr><td colspan="2" style="text-align: center;">N</td></tr> <tr><td style="text-align: center;">W</td><td style="text-align: center;">X</td></tr> <tr><td colspan="2" style="text-align: center;">E</td></tr> <tr><td style="text-align: center;">SW</td><td style="text-align: center;">SE</td></tr> <tr><td colspan="2" style="text-align: center;">S</td></tr> </table> 4 DEPTH OF WELL 61 ft. WELL'S STATIC WATER LEVEL Dry ft. WELL WAS USED AS: <table style="margin-left: 20px;"> <tr><td>1 Domestic</td><td>5 Public Water Supply</td></tr> <tr><td>2 Irrigation</td><td>6 Oil Field Water Supply</td></tr> <tr><td>3 Feedlot</td><td>7 Lawn and Garden (domestic)</td></tr> <tr><td>4 Industrial</td><td>8 Air Conditioning</td></tr> </table> 9 Dewatering 10 Monitoring Well 11 Injection Well 12 Other				N		W	X	E		SW	SE	S		1 Domestic	5 Public Water Supply	2 Irrigation	6 Oil Field Water Supply	3 Feedlot	7 Lawn and Garden (domestic)	4 Industrial	8 Air Conditioning																														
N	
W	X	
E	
SW	SE	
S	
1 Domestic	5 Public Water Supply	
2 Irrigation	6 Oil Field Water Supply	
3 Feedlot	7 Lawn and Garden (domestic)	
4 Industrial	8 Air Conditioning	
Was a chemical/bacteriological sample submitted to Department? Yes <input type="checkbox"/> No <input checked="" type="checkbox"/> If yes, mo/day/yr sample was submitted _____ Water Well Disinfected: Yes <input type="checkbox"/> No <input checked="" type="checkbox"/>	
5 TYPE OF BLANK CASING USED: 1 Steel 3 RMP (SR) 5 Wrought 7 Fiberglass 9 Other (specify below) 2 PVC 4 ABC 6 Asbestos-Cement 8 Concrete Tile Blank casing diameter 2 in. Was casing pulled? Yes <input checked="" type="checkbox"/> No <input type="checkbox"/> If yes, how much Overdrill 3 ft Casing height above or below land surface -36 in.	
6 GROUT PLUG MATERIAL: 1 Neat cement 2 Cement grout 3)Bentonite 4 Other Grout Plug Intervals From 0 ft. to 61 ft. From ft. to ft. From ft. to ft.	
What is the nearest source of possible contamination: <table style="margin-left: 20px;"> <tr><td>1 Septic tank</td><td>6 Seepage pit</td><td>11 Fuel storage</td><td>16 Other (specify below) Previously Contaminated Site</td></tr> <tr><td>2 Sewer lines</td><td>7 Pit privy</td><td>12 Fertilizer storage</td><td></td></tr> <tr><td>3 Watertight sewer lines</td><td>8 Sewage lagoon</td><td>13 Insecticide storage</td><td></td></tr> <tr><td>4 Lateral lines</td><td>9 Feedyard</td><td>14 Abandoned water well</td><td></td></tr> <tr><td>5 Cess Pool</td><td>10 Livestock pens</td><td>15 Oil well/ Gas well</td><td></td></tr> </table>						1 Septic tank	6 Seepage pit	11 Fuel storage	16 Other (specify below) Previously Contaminated Site	2 Sewer lines	7 Pit privy	12 Fertilizer storage		3 Watertight sewer lines	8 Sewage lagoon	13 Insecticide storage		4 Lateral lines	9 Feedyard	14 Abandoned water well		5 Cess Pool	10 Livestock pens	15 Oil well/ Gas well																													
1 Septic tank	6 Seepage pit	11 Fuel storage	16 Other (specify below) Previously Contaminated Site	
2 Sewer lines	7 Pit privy	12 Fertilizer storage	
3 Watertight sewer lines	8 Sewage lagoon	13 Insecticide storage	
4 Lateral lines	9 Feedyard	14 Abandoned water well	
5 Cess Pool	10 Livestock pens	15 Oil well/ Gas well	
Direction from well? How many feet?	
<table border="1" style="width: 100%; border-collapse: collapse;"> <thead> <tr> <th style="width: 10%;">FROM</th> <th style="width: 10%;">TO</th> <th style="width: 10%;">CODE</th> <th colspan="3" style="width: 60%;">PLUGGING MATERIALS</th> </tr> </thead> <tbody> <tr><td>61</td><td>3</td><td></td><td colspan="3">Bentonite</td></tr> <tr><td>3</td><td>0</td><td></td><td colspan="3">Native Soil</td></tr> <tr><td> </td><td> </td><td> </td><td> </td><td> </td><td> </td></tr> </tbody> </table>						FROM	TO	CODE	PLUGGING MATERIALS			61	3		Bentonite			3	0		Native Soil																																
FROM	TO	CODE	PLUGGING MATERIALS	
61	3		Bentonite	
3	0		Native Soil	
7	CONTRACTOR'S OR LANDOWNER'S CERTIFICATION: This water well was plugged under my jurisdiction and was completed on (mo/day/yr) 5/16/06 and this record is true to the best of my knowledge and belief. Kansas Water Well Contractor's License No. 554 This Water Well Record was completed on (mo/day/yr) 6/26/06 under the business name of Woofter Pump & Well Inc. by (signature) 	
INSTRUCTIONS: Please fill in blanks and circle the correct answers. Send three copies to Kansas Department of Health and Environment, Bureau of Water, 1000 S W Jackson St., Ste. 420, Topeka, Kansas 66620-0001. Telephone: 785-296-3565. Send one to Water Well Owner and retain one for your records.	