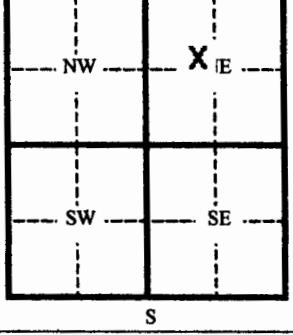


## WATER WELL PLUGGING RECORD

**Form WWC-5P**

KSA 82a-1212

ID No. **MW11**

1 LOCATION OF WATER WELL:	Fraction SE 1/4 NW 1/4 NE 1/4		Section Number 11	Township Number 26	Range Number 28	
Distance and direction from nearest town or city street address of well if located within city?						
2 WATER WELL OWNER:	Grain Growers Coop		Board of Agriculture, Division of Water Resources			
RR#, St. Address, Box #	202 N Main		Application Number:			
City, State, ZIP Code		Cimarron, KS 67835				
3 MARK WELL'S LOCATON WITH AN "X" IN SECTION BOX:			4 DEPTH OF WELL	63	ft.	
			WELL'S STATIC WATER LEVEL	Dry	ft.	
			WELL WAS USED AS:			
			1 Domestic	5 Public Water Supply	9 Dewatering	
			2 Irrigation	6 Oil Field Water Supply	10 Monitoring Well	
			3 Feedlot	7 Lawn and Garden (domestic)	11 Injection Well	
			4 Industrial	8 Air Conditioning	12 Other	
			Was a chemical/bacteriological sample submitted to Department?			
			If yes, mo/day/yr sample was submitted			
			Water Well Disinfected: Yes <input checked="" type="checkbox"/> No <input checked="" type="checkbox"/>			
5 TYPE OF BLANK CASING USED:	1 Steel      3 RMP (SR)      5 Wrought      7 Fiberglass      9 Other (specify below) <input checked="" type="radio"/> 2 PVC      4 ABC      6 Asbestos-Cement      8 Concrete Tile					
Blank casing diameter	2	in.	Was casing pulled?	Yes <input checked="" type="checkbox"/>	No <input type="checkbox"/>	
If yes, how much <u>Overdrilled 3 ft</u>						
Casing height above or below land surface <u>-36</u> in.						
6 GROUT PLUG MATERIAL:	1 Neat cement	2 Cement grout	<input checked="" type="radio"/> 3 Bentonite	4 Other		
Grout Plug Intervals	From <u>0</u> ft. to <u>63</u> ft.	From	ft. to	ft. From	ft. to	
What is the nearest source of possible contamination:						
1 Septic tank	6 Seepage pit	11 Fuel storage	16 Other (specify below)			
2 Sewer lines	7 Pit privy	12 Fertilizer storage	<input checked="" type="radio"/> Previously Contaminated Site			
3 Watertight sewer lines	8 Sewage lagoon	13 Insecticide storage				
4 Lateral lines	9 Feedyard	14 Abandoned water well				
5 Cess Pool	10 Livestock pens	15 Oil well/ Gas well				
Direction from well?			How many feet?			
FROM	TO	CODE	PLUGGING MATERIALS			
63	3		<b>Bentonite</b>			
3	0		<b>Native Soil</b>			
7	CONTRACTOR'S OR LANDOWNER'S CERTIFICATION: This water well was plugged under my jurisdiction and was completed on (mo/day/yr) <u>5/16/06</u> and this record is true to the best of my knowledge and belief. Kansas Water Well Contractor's License No. <u>554</u> This Water Well Record was completed on (mo/day/yr) <u>6/26/06</u> under the business name of <u>Woofter Pump &amp; Well Inc.</u>					
by (signature) <u>Jeff G. Woofter</u>						
INSTRUCTIONS: Please fill in blanks and circle the correct answers. Send three copies to Kansas Department of Health and Environment, Bureau of Water, 1000 S W Jackson St., Ste. 420, Topeka, Kansas 66620-0001. Telephone: 785-296-3565. Send one to Water Well Owner and retain one for your records.						

**INSTRUCTIONS:** Please fill in blanks and circle the correct answers. Send three copies to Kansas Department of Health and Environment, Bureau of Water, 1000 S W Jackson St., Ste. 420, Topeka, Kansas 66620-0001. Telephone: 785-296-3565. Send one to Water Well Owner and retain one for your records.