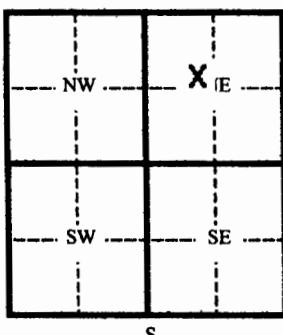


WATER WELL PLUGGING RECORD

Form WWC-5P

KSA 82a-1212

ID No. **MW17A**

1 LOCATION OF WATER WELL:		Fraction County: Gray SE $\frac{1}{4}$ NW $\frac{1}{4}$ NE $\frac{1}{4}$		Section Number 11	Township Number 26	Range Number 28	
Distance and direction from nearest town or city street address of well if located within city?	
2 WATER WELL OWNER:		Grain Growers Coop RR#, St. Address, Box # 202 N Main City, State, ZIP Code Cimarron, KS 67835		Board of Agriculture, Division of Water Resources Application Number:	
3 MARK WELL'S LOCATON WITH AN "X" IN SECTION BOX:				4 DEPTH OF WELL 55 ft.	WELL'S STATIC WATER LEVEL Dry ft.	
				WELL WAS USED AS:	
				1 Domestic 2 Irrigation 3 Feedlot 4 Industrial	5 Public Water Supply 6 Oil Field Water Supply 7 Lawn and Garden (domestic) 8 Air Conditioning	9 Dewatering 10 Monitoring Well 11 Injection Well 12 Other	
				Was a chemical/bacteriological sample submitted to Department? If yes, mo/day/yr sample was submitted	
				Water Well Disinfected: Yes <input checked="" type="checkbox"/> No <input checked="" type="checkbox"/>	
5 TYPE OF BLANK CASING USED:	
1 Steel <input checked="" type="radio"/> 2 PVC		3 RMP (SR) 4 ABC		5 Wrought 6 Asbestos-Cement	7 Fiberglass 8 Concrete Tile	9 Other (specify below)	
Blank casing diameter 2 in.				Was casing pulled? Yes <input checked="" type="checkbox"/> No <input type="checkbox"/> If yes, how much Overdrilled 3 ft	
Casing height above or below land surface -36 in.	
6 GROUT PLUG MATERIAL: 1 Neat cement 2 Cement grout <input checked="" type="radio"/> 3 Bentonite 4 Other	
Grout Plug Intervals From 0 ft. to 55 ft. From ft. to ft. From ft. to ft.	
What is the nearest source of possible contamination:	
1 Septic tank 2 Sewer lines 3 Watertight sewer lines 4 Lateral lines 5 Cess Pool		6 Seepage pit 7 Pit privy 8 Sewage lagoon 9 Feedyard 10 Livestock pens		11 Fuel storage 12 Fertilizer storage 13 Insecticide storage 14 Abandoned water well 15 Oil well/ Gas well		16 Other (specify below) Previously Contaminated Site	
Direction from well? How many feet?	
<table border="1"> <thead> <tr> <th>FROM</th> <th>TO</th> <th>CODE</th> <th colspan="4">PLUGGING MATERIALS</th> </tr> </thead> <tbody> <tr> <td>55</td> <td>3</td> <td></td> <td colspan="4">Bentonite</td> </tr> <tr> <td>3</td> <td>0</td> <td></td> <td colspan="4">Native Soil</td> </tr> <tr><td> </td><td> </td><td> </td><td colspan="4"> </td></tr> </tbody> </table>							FROM	TO	CODE	PLUGGING MATERIALS				55	3		Bentonite				3	0		Native Soil																																						
FROM	TO	CODE	PLUGGING MATERIALS	
55	3		Bentonite	
3	0		Native Soil	
7 CONTRACTOR'S OR LANDOWNER'S CERTIFICATION: This water well was plugged under my jurisdiction and was completed on (mo/day/yr) 5/16/06 and this record is true to the best of my knowledge and belief. Kansas Water Well Contractor's License No. 554 This Water Well Record was completed on (mo/day/yr) 6/26/06 under the business name of Woofter Pump & Well Inc. by (signature) 	
INSTRUCTIONS: Please fill in blanks and circle the correct answers. Send three copies to Kansas Department of Health and Environment, Bureau of Water, 1000 S W Jackson St., Ste. 420, Topeka, Kansas 66620-0001. Telephone: 785-296-3565. Send one to Water Well Owner and retain one for your records.	