

WATER WELL PLUGGING RECORD

Form WWC-5P

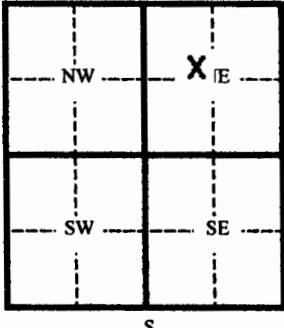
KSA 82a-1212

ID No. MW19

1 LOCATION OF WATER WELL:	Fraction County: Gray SE $\frac{1}{4}$ NW $\frac{1}{4}$ NE $\frac{1}{4}$	Section Number 11	Township Number 26	Range Number 28
---------------------------	--	----------------------	-----------------------	--------------------

Distance and direction from nearest town or city street address of well if located within city?

2 WATER WELL OWNER: Grain Growers Coop RR#, St. Address, Box # 202 N Main City, State, ZIP Code Cimarron, KS 67835	Board of Agriculture, Division of Water Resources Application Number:
---	--

3 MARK WELL'S LOCATON WITH AN "X" IN SECTION BOX: 	4 DEPTH OF WELL 57 ft. WELL'S STATIC WATER LEVEL Dry ft. WELL WAS USED AS: 1 Domestic 5 Public Water Supply 2 Irrigation 6 Oil Field Water Supply 3 Feedlot 7 Lawn and Garden (domestic) 4 Industrial 8 Air Conditioning Was a chemical/bacteriological sample submitted to Department? Yes _____ No X If yes, mo/day/yr sample was submitted _____ Water Well Disinfected: Yes _____ No X	9 Dewatering 10 Monitoring Well 11 Injection Well 12 Other _____
---	---	--

5 TYPE OF BLANK CASING USED: 1 Steel 3 RMP (SR) 2 PVC 4 ABC	5 Wrought 7 Fiberglass 6 Asbestos-Cement 8 Concrete Tile	9 Other (specify below) Blank casing diameter 2 in. Was casing pulled? Yes X No _____ If yes, how much Overdrilled 20 ft
Casing height above or below land surface -20 ft in.		

6 GROUT PLUG MATERIAL: 1 Neat cement 2 Cement grout 3 Bentonite 4 Other
Grout Plug Intervals From 0 ft. to 57 ft. From _____ ft. to _____ ft. From _____ ft. to _____ ft.

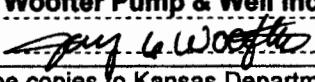
What is the nearest source of possible contamination:

1 Septic tank	6 Seepage pit	11 Fuel storage	16 Other (specify below) Previously Contaminated Site
2 Sewer lines	7 Pit privy	12 Fertilizer storage	
3 Watertight sewer lines	8 Sewage lagoon	13 Insecticide storage	
4 Lateral lines	9 Feedyard	14 Abandoned water well	
5 Cess Pool	10 Livestock pens	15 Oil well/ Gas well	

Direction from well? _____

How many feet? _____

FROM	TO	CODE	PLUGGING MATERIALS
57	3		Bentonite
3	0		Native Soil

7 CONTRACTOR'S OR LANDOWNER'S CERTIFICATION: This water well was plugged under my jurisdiction and was completed on (mo/day/yr) 5/16/06 and this record is true to the best of my knowledge and belief. Kansas Water Well Contractor's License No. 554 This Water Well Record was completed on (mo/day/yr) 6/26/06 under the business name of Woofter Pump & Well Inc. by (signature) 
--

INSTRUCTIONS: Please fill in blanks and circle the correct answers. Send three copies to Kansas Department of Health and Environment, Bureau of Water, 1000 S W Jackson St., Ste. 420, Topeka, Kansas 66620-0001. Telephone: 785-296-3565. Send one to Water Well Owner and retain one for your records.