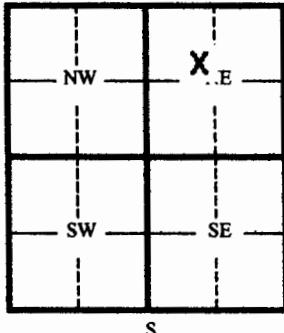
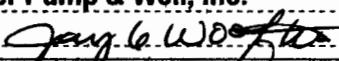


WATER WELL PLUGGING RECORD

Form WWC-5P

KSA 82a-1212

ID No. **OBW-1**

1 LOCATION OF WATER WELL:		Fraction SE 1/4 NW 1/4 NE 1/4	Section Number 11	Township Number 26	Range Number 28																																				
Distance and direction from nearest town or city street address of well if located within city?	
2 WATER WELL OWNER: Grain Growers Coop RR#, St. Address, Box # 202 N. Main Board of Agriculture, Division of Water Resources City, State, ZIP Code : Cimarron, KS 67835 Application Number:	
3 MARK WELL'S LOCATON WITH AN "X" IN SECTION BOX: 	
4 DEPTH OF WELL 65 ft. WELL'S STATIC WATER LEVEL dry ft. WELL WAS USED AS:	
<table> <tbody> <tr><td>1 Domestic</td><td>5 Public Water Supply</td><td>9 Dewatering</td></tr> <tr><td>2 Irrigation</td><td>6 Oil Field Water Supply</td><td>10 Monitoring Well</td></tr> <tr><td>3 Feedlot</td><td>7 Lawn and Garden (domestic)</td><td>11 Injection Well</td></tr> <tr><td>4 Industrial</td><td>8 Air Conditioning</td><td>12 Other</td></tr> </tbody> </table>						1 Domestic	5 Public Water Supply	9 Dewatering	2 Irrigation	6 Oil Field Water Supply	10 Monitoring Well	3 Feedlot	7 Lawn and Garden (domestic)	11 Injection Well	4 Industrial	8 Air Conditioning	12 Other																								
1 Domestic	5 Public Water Supply	9 Dewatering																																							
2 Irrigation	6 Oil Field Water Supply	10 Monitoring Well																																							
3 Feedlot	7 Lawn and Garden (domestic)	11 Injection Well																																							
4 Industrial	8 Air Conditioning	12 Other																																							
Was a chemical/bacteriological sample submitted to Department? Yes <input type="checkbox"/> No <input checked="" type="checkbox"/>	
If yes, mo/day/yr sample was submitted	
Water Well Disinfected: Yes <input type="checkbox"/> No <input checked="" type="checkbox"/>	
5 TYPE OF BLANK CASING USED: <table> <tbody> <tr><td>1 Steel</td><td>3 RMP (SR)</td><td>5 Wrought</td><td>7 Fiberglass</td><td>9 Other (specify below)</td></tr> <tr><td><input checked="" type="radio"/> PVC</td><td>4 ABC</td><td>6 Asbestos-Cement</td><td>8 Concrete Tile</td><td></td></tr> </tbody> </table>						1 Steel	3 RMP (SR)	5 Wrought	7 Fiberglass	9 Other (specify below)	<input checked="" type="radio"/> PVC	4 ABC	6 Asbestos-Cement	8 Concrete Tile																											
1 Steel	3 RMP (SR)	5 Wrought	7 Fiberglass	9 Other (specify below)																																					
<input checked="" type="radio"/> PVC	4 ABC	6 Asbestos-Cement	8 Concrete Tile																																						
Blank casing diameter 2 in. Was casing pulled? Yes <input checked="" type="checkbox"/> No <input type="checkbox"/> If yes, how much Overdrilled 3 ft	
Casing height above or below land surface -36 in.	
6 GROUT PLUG MATERIAL: 1 Neat cement 2 Cement grout <input checked="" type="radio"/> 3 Bentonite 4 Other	
Grout Plug Intervals From 65 ft. to 3 ft. From _____ ft. to _____ ft. From _____ ft. to _____ ft.	
What is the nearest source of possible contamination: <table> <tbody> <tr><td>1 Septic tank</td><td>6 Seepage pit</td><td>11 Fuel storage</td><td>16 Other (specify below)</td></tr> <tr><td>2 Sewer lines</td><td>7 Pit privy</td><td>12 Fertilizer storage</td><td>Previously Contaminated Site</td></tr> <tr><td>3 Watertight sewer lines</td><td>8 Sewage lagoon</td><td>13 Insecticide storage</td><td></td></tr> <tr><td>4 Lateral lines</td><td>9 Feedyard</td><td>14 Abandoned water well</td><td></td></tr> <tr><td>5 Cess Pool</td><td>10 Livestock pens</td><td>15 Oil well/ Gas well</td><td></td></tr> </tbody> </table>						1 Septic tank	6 Seepage pit	11 Fuel storage	16 Other (specify below)	2 Sewer lines	7 Pit privy	12 Fertilizer storage	Previously Contaminated Site	3 Watertight sewer lines	8 Sewage lagoon	13 Insecticide storage		4 Lateral lines	9 Feedyard	14 Abandoned water well		5 Cess Pool	10 Livestock pens	15 Oil well/ Gas well																	
1 Septic tank	6 Seepage pit	11 Fuel storage	16 Other (specify below)																																						
2 Sewer lines	7 Pit privy	12 Fertilizer storage	Previously Contaminated Site																																						
3 Watertight sewer lines	8 Sewage lagoon	13 Insecticide storage																																							
4 Lateral lines	9 Feedyard	14 Abandoned water well																																							
5 Cess Pool	10 Livestock pens	15 Oil well/ Gas well																																							
Direction from well? _____ How many feet? _____	
<table border="1"> <thead> <tr> <th>FROM</th> <th>TO</th> <th>CODE</th> <th>PLUGGING MATERIALS</th> </tr> </thead> <tbody> <tr><td>65</td><td>3</td><td></td><td>Bentonite Grout</td></tr> <tr><td>3</td><td>0</td><td></td><td>Native Soil</td></tr> <tr><td> </td><td> </td><td> </td><td> </td></tr> </tbody> </table>						FROM	TO	CODE	PLUGGING MATERIALS	65	3		Bentonite Grout	3	0		Native Soil																								
FROM	TO	CODE	PLUGGING MATERIALS																																						
65	3		Bentonite Grout																																						
3	0		Native Soil																																						
7 CONTRACTOR'S OR LANDOWNER'S CERTIFICATION: This water well was plugged under my jurisdiction and was completed on (mo/day/yr) 5-16-06 and this record is true to the best of my knowledge and belief. Kansas Water Well Contractor's License No. 554 This Water Well Record was completed on (mo/day/yr) 6-26-06 under the business name of Woofter Pump & Well, Inc. by (signature) 	
INSTRUCTIONS: Please fill in blanks and circle the correct answers. Send three copies to Kansas Department of Health and Environment, Bureau of Water, 1000 S W Jackson St., Ste. 420, Topeka, Kansas 66620-0001. Telephone: 785-296-3565. Send one to Water Well Owner and retain one for your records.	