

## WATER WELL PLUGGING RECORD

Form WWC-5P

KSA 82a-1212

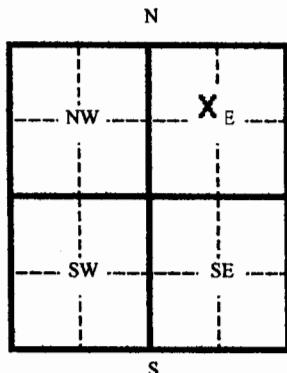
ID No. AS 8

1 LOCATION OF WATER WELL:		Fraction <b>SE 1/4 NW 1/4 NE 1/4</b>	Section Number <b>11</b>	Township Number <b>26</b>	Range Number <b>28</b>
---------------------------	--	---	-----------------------------	------------------------------	---------------------------

Distance and direction from nearest town or city street address of well if located within city?

2 WATER WELL OWNER: **Grain Growers Coop**RR#, St. Address, Box # **202 N. Main**City, State, ZIP Code : **Cimarron, Ks 67835**Board of Agriculture, Division of Water Resources  
Application Number: **AS-8**

3 MARK WELL'S LOCATON WITH AN "X" IN SECTION BOX:

4 DEPTH OF WELL **58** ft.WELL'S STATIC WATER LEVEL **unknown** ft.

WELL WAS USED AS:

1 Domestic	5 Public Water Supply	9 Dewatering
2 Irrigation	6 Oil Field Water Supply	10 Monitoring Well
3 Feedlot	7 Lawn and Garden (domestic)	11 Injection Well
4 Industrial	8 Air Conditioning	12 Other <b>Air Sparge</b>

Was a chemical/bacteriological sample submitted to Department?

Yes  No If yes, mo/day/yr sample was submitted Water Well Disinfected: Yes  No 

5 TYPE OF BLANK CASING USED:

1 Steel	3 RMP (SR)
<input checked="" type="checkbox"/> 2 PVC	4 ABC

5 Wrought	7 Fiberglass
6 Asbestos-Cement	8 Concrete Tile

9 Other (specify below)

Blank casing diameter  in.Was casing pulled? Yes  No  If yes, how much **3 ft**Casing height above or below land surface **~36** in.

6 GROUT PLUG MATERIAL: 1 Neat cement 2 Cement grout

 3 Bentonite 4 Other Grout Plug Intervals From **58** ft. to **3** ft. From  ft. to  ft. From  ft. to  ft.

What is the nearest source of possible contamination:

1 Septic tank	6 Seepage pit	11 Fuel storage	16 Other (specify below)
2 Sewer lines	7 Pit privy	12 Fertilizer storage	<b>      </b>
3 Watertight sewer lines	8 Sewage lagoon	13 Insecticide storage	<b>      </b>
4 Lateral lines	9 Feedyard	14 Abandoned water well	<b>      </b>
5 Cess Pool	10 Livestock pens	15 Oil well/ Gas well	<b>      </b>

Direction from well? How many feet? 

FROM	TO	CODE	PLUGGING MATERIALS
<b>58</b>	<b>3</b>		<b>bentonite</b>
<b>3</b>	<b>0</b>		<b>Over burden soil</b>
			<b>Over drilled to 3 ft</b>
			<b>      </b>

7 CONTRACTOR'S OR LANDOWNER'S CERTIFICATION: This water well was plugged under my jurisdiction and was completed on (mo/day/yr) **5 30 06** and this record is true to the best of my knowledge and belief. KansasWater Well Contractor's License No. **554** This Water Well Record was completed on (mo/day/yr)**6-23-06** under the business name of **Woofter Pump & Well Inc.**by (signature) 

INSTRUCTIONS: Please fill in blanks and circle the correct answers. Send three copies to Kansas Department of Health and Environment, Bureau of Water, 1000 S W Jackson St., Ste. 420, Topeka, Kansas 66620-0001. Telephone: 785-296-3565. Send one to Water Well Owner and retain one for your records.