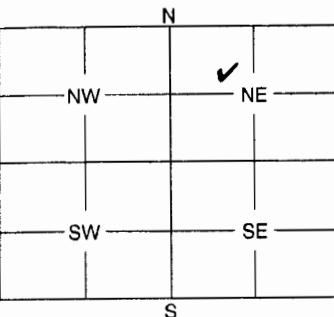


WATER WELL PLUGGING RECORD Form WWC-5P KSA 82a-1212 ID NO. 0041368

1	LOCATION OF WATER WELL:	Fraction	Section Number	Township Number	Range Number
County: Gray		SE $\frac{1}{4}$ NW $\frac{1}{4}$ NE $\frac{1}{4}$	11	26S	28
Distance and direction from nearest town or city street address of well if located within city?					

111 E. Ave A Cimarron, KS

2	WATER WELL OWNER: Presto Convenience Stores Box 609	RR #, St. Address, Box #: Andover, KS 67002	Board of Agriculture, Division of Water Resources Application Number:
---	--	---	--

3	MARK WELL'S LOCATION WITH AN "X" IN SECTION BOX:	4 DEPTH OF WELL 63.54 ft.												
		WELL'S STATIC WATER LEVEL 51.11 ft.												
WELL WAS USED AS:														
<table border="0"> <tr> <td>1 Domestic</td> <td>5 Public Water Supply</td> <td>9 Dewatering</td> </tr> <tr> <td>2 Irrigation</td> <td>6 Oil Field Water Supply</td> <td>10 Monitoring Well MW-8</td> </tr> <tr> <td>3 Feedlot</td> <td>7 Domestic (Lawn & Garden)</td> <td>11 Injection Well</td> </tr> <tr> <td>4 Industrial</td> <td>8 Air Conditioning</td> <td>12 Other</td> </tr>
Was a chemical / bacteriological sample submitted to Department? Yes No ✓														
If yes, mo/day/yr sample was submitted														
Water Well Disinfected: Yes No ✓														

5	TYPE OF BLANK CASING USED:													
<table border="0"> <tr> <td>1 Steel</td> <td>3 RMP (SR)</td> <td>5 Wrought</td> <td>7 Fiberglass</td> <td>9 Other (Specify below)</td> </tr> <tr> <td><input checked="" type="checkbox"/> 2 PVC</td> <td>4 ABS</td> <td>6 Asbestos-Cement</td> <td>8 Concrete Tile</td> <td>.....</td> </tr>
Blank casing diameter 2 in. Was casing pulled? Yes ✓ No If yes, how much 3'														
Casing height above or below land surface 40 in.														

6	GROUT PLUG MATERIAL: 1 Neat cement 2 Cement grout 3 Bentonite 4 Other				
Grout Plug Intervals: From 0.5 ft. to 63.54 ft., From ft. to ft., From ft. to ft.					

What is the nearest source of possible contamination:

1 Septic tank	6 Seepage pit	11 Fuel storage	16 Other (specify below)
2 Sewer lines	7 Pit privy	12 Fertilizer storage
3 Watertight sewer lines	8 Sewage lagoon	13 Insecticide storage
4 Lateral lines	9 Feedyard	14 Abandoned water well
5 Cess pool	10 Livestock pens	15 Oil well/Gas well

Direction from well? NE How many feet? 150

FROM	TO	PLUGGING MATERIALS
0	0.5	Concrete
0.5	63.54	Bentonite Slurry

7	CONTRACTOR'S OR LANDOWNER'S CERTIFICATION: This water well was plugged under my jurisdiction and was completed on (mo/day/year) 7-8-08 and this record is true to the best of my knowledge and belief. Kansas Water Well Contractor's License No. 754735 This Water Well Record was completed on (mo/day/year) 7-16-08 under the business name of MILCO Environmental Services, Inc. by (signature) D. T. Ray				
---	---	--	--	--	--

INSTRUCTIONS: Use typewriter or ball point pen. Please press firmly and print clearly. Please fill in blanks, underline or circle the correct answers. Send top three copies to Kansas Department of Health and Environment, Bureau of Water, Geology Section, 1000 SW Jackson St., Ste. 420, Topeka, Kansas 66612-1367. Telephone: 785/296-5522. Send one to Water Well Owner and retain one for your records.