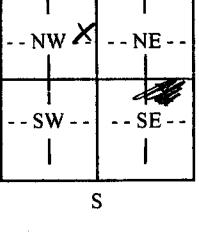
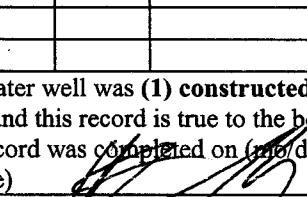


## **WATER WELL RECORD**

**Form WWC-5**

### Division of Water Resources: App. No.

<b>1 LOCATION OF WATER WELL:</b> County: Gray		Fraction SE ¼ NE ¼ NW ¼	Section Number 11	Township Number T 26 S	Range Number R 28 (W)	
Distance and direction from nearest town or city street address of well if located within city? 402 West Avenue A, Cimarron, KS			Global Positioning Systems (decimal degrees, min. of 4 digits) Latitude: _____ Longitude: _____ Elevation: _____ Datum: _____ Data Collection Method: _____			
<b>2 WATER WELL OWNER:</b> Jake Osborn RR#, St. Address, Box # : PO BOX 492 City, State, ZIP Code : Cimarron, KS 67835						
<b>3 LOCATE WELL'S LOCATION WITH AN "X" IN SECTION BOX:</b>		<b>4 DEPTH OF COMPLETED WELL</b> ..... 62.0' ..... ft.				
		Depth(s) Groundwater Encountered (1)...~55'..... ft. (2)..... ft. (3)..... ft. <b>WELL'S STATIC WATER LEVEL</b> ....51.20.... ft. below land surface measured on mo/day/yr..09/09/2008... Pump test data: Well water was..... ft. after..... hours pumping..... gpm Est. Yield.....gpm: Well water was..... ft. after..... hours pumping..... gpm <b>WELL WATER TO BE USED AS:</b> 5 Public water supply 8 Air conditioning 11 Injection well 1 Domestic 3 Feedlot 6 Oil field water supply 9 Dewatering 12 Other (Specify below) 2 Irrigation 4 Industrial 7 Domestic (lawn & garden) 10 Monitoring well .....  Was a chemical/bacteriological sample submitted to Department? Yes ..... No ...X...; If yes, mo/day/ys Sample was submitted..... Water well disinfected? Yes ..... No ...X.... 				
<b>5 TYPE OF CASING USED:</b>		5 Wrought Iron 1 Steel 2 PVC	8 Concrete tile 6 Asbestos-Cement 7 Fiberglass	CASING JOINTS: Glued..... Clamped..... Welded..... Threaded..... X.....		
Blank casing diameter ..... 2.... in. to ..... 62'..... ft., Diameter. .... in. to ..... ft., Diameter ..... in. to ..... ft.		Casing height below land surface..... 2.40..... in., Weight ..... lbs./ft. Wall thickness or guage No. Sch. 40 PVC.....				
<b>TYPE OF SCREEN OR PERFORATION MATERIAL:</b>						
1 Steel 2 Brass		3 Stainless Steel 4 Galvanized Steal	5 Fiberglass 6 Concrete tile	7 PVC 8 RM (SR)	9 ABS 10 Asbestos-Cement	11 Other (Specify) ..... 12 None used (open hole).....
<b>SCREEN OR PERFORATION OPENINGS ARE:</b>						
1 Continuous slot 2 Louvered shutter		3 Mill slot 4 Key punched	5 Gauzed wrapped 6 Wire wrapped	7 Torch cut 8 Saw cut	9 Drilled holes 10 Other (specify).....	11 None (open hole).....
<b>SCREEN-PERFORATED INTERVALS:</b> From..... 42 ..... ft. to ..... 62 ..... ft., From ..... ft. to ..... ft.						
From ..... ft. to ..... ft., From ..... ft. to ..... ft.						
<b>GRAVEL PACK INTERVALS:</b> From..... 40 ..... ft. to ..... 65 ..... ft., From ..... ft. to ..... ft.						
From ..... ft. to ..... ft., From ..... ft. to ..... ft.						
<b>6 GROUT MATERIAL:</b> 1 Neat cement 2 Cement grout 3 Bentonite 4 Other .....						
Grout Intervals: From ..... 1 ..... ft. to ..... 40 ..... ft., From ..... ft. to ..... ft., From ..... ft. to ..... ft.						
What is the nearest source of possible contamination:						
1 Septic tank 2 Sewer lines 3 Watertight sewer lines		4 Lateral lines 5 Cess pool 6 Seepage pit	7 Pit privy 8 Sewage lagoon 9 Feedyard	10 Livestock pens 11 Fuel storage 12 Fertilizer storage	13 Insecticide storage 14 Abandoned water well ..... below) 15 Oil well/gas well ..... Lust site....	
Direction from well? ..... How many feet? .....						
FROM	TO	LITHOLOGIC LOG		FROM	TO	PLUGGING INTERVALS
0	12	Clay, silty				
12	23	Clay, caliche nodules				
23	37	Clay, silty				
37	40	Clay with fine sands to medium gravels				
40	50	Gravel, medium to coarse, moderate clays				MW 22
50	57	Sand, fine to coarse, gravels, some clays				
57	60	Clay with fine sands to medium gravels				
60	65	Sandy clay				
<b>7 CONTRACTOR'S OR LANDOWNER'S CERTIFICATION:</b> This water well was (1) constructed, (2) reconstructed, or (3) plugged under my jurisdiction and was completed on (mo/day/year) ...09/08/2008.. and this record is true to the best of my knowledge and belief. Kansas Water Well Contractor's License No. ...594... This Water Well Record was completed on (mo/day/year) ...10/01/2008 under the business name of Coranco Great Plains, Inc. by (signature) 						
<b>INSTRUCTIONS:</b> Use typewriter or ball point pen. <b>PLEASE PRESS FIRMLY</b> and <b>PRINT</b> clearly. Please fill in blanks, underline or circle the correct answers. Send top three copies to Kansas Department of Health and Environment, Bureau of Water, Geology Section, 1000 SW Jackson St., Suite 420, Topeka, Kansas 66612-1367. Telephone 785-296-5522. Send one to WATER WELL OWNER and retain one for your records. Fee of \$5.00 for each <u>constructed</u> well. Visit us at <a href="http://www.kdheks.gov/waterwell/index.html">http://www.kdheks.gov/waterwell/index.html</a> .						



